

MISSISSIPPI DEPARTMENT OF NATURAL RESOURCES

Bureau of Land and Water Resources

Southport Mall

P.O. Box 10631

Jackson, Mississippi 39209

WATER WELL DRILLERS LOG

CODED

WALTHALL
F99
3-19-85

Griner Drilling Service, INC.

Walthall

3-19-85
date well completed

Griner Drilling Service, INC.
firm name

Walthall
county well located


LANDOWNER:	description of formations encountered	from	to
See Land Drilling Co. 900 Dunn Street Houma, La. 70360 (mailing address)			
WELL LOCATION: 1980'S & 1980'E sec. 7 T. 20N R. 11E of No. 1 Old Hwy. Tylertown Hwy. 101 (direction) (nearest town)	clay, streaked	126	252
WELL PURPOSE: oil field supply (home, irrigation, municipal, industrial)	SAND	252	357
WELL COMPLETION DATA:			
(1) diameter (inches) 3"			
(2) total depth (feet) 357'			
(3) static water level (feet) 20' below top of ground.			
(4) casing steel 357' (material), (depth)			
3" (size) If telescope see back.			
(5) screen 42' length, 315' depth to top			
3" perforated (size), (material)			
(6) pump — 75-80 (HP), (yield gpm)			
AC (type power)			
(7) electric log (yes or no)			
(organization running log)			
(8) how well bottom plugged orange			
peel			
DRILLERS REMARKS:			

RECEIVED
MAR 25 1985

Department of Natural Resources
Bureau of Land & Water Resources

If well telescopes please sketch and show depths.

GROUND LEVEL

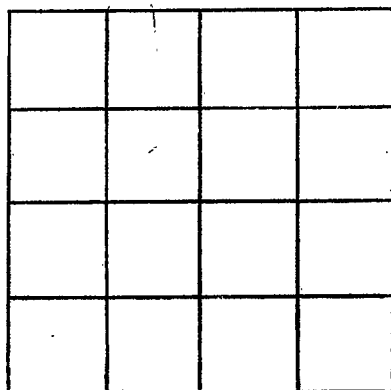

SECTION _____

Please indicate well location X.

ADDITIONAL INFORMATION

If more than one screen, show locations of each on sketch.