

MISSISSIPPI DEPARTMENT OF ENVIRONMENTAL QUALITY

Office of Land and Water Resources

P. O. Box 10631
Jackson, MS 39289-0631
WATER WELL DRILLERS LOG

COUNTY WELL LOCATED
Waltham

WELL NUMBER
F-101

CODED

PERMIT NUMBER

NAME OF DRILLING FIRM
 Fitzgerald Well Service

DATE WELL COMPLETED
4-1-03

NAME & MAILING ADDRESS OF LANDOWNER
Brian Guy DeLong
Carlo Rd

Latitude:
Longitude:

WELL LOCATION. SEC. TOWNSHIP RANGE
24 2 S 11 E

DISTANCE DIRECTION NEAREST TOWN
5 Miles *East* of *Kylebour*

OTHER LANDMARK

WELL PURPOSE: Home, Irrigation, Municipal, Industrial, Fish Pond, etc.

PUMP DATA

PUMP TYPE (Circle One):
 Submersible, Turbine, Jet, Flowing Well,
Other (Describe)

POWER TYPE (Circle One):
 Electric, Tractor, Diesel, Gasoline, Butane,
Other (Describe) *H/P 1*

DESCRIPTION OF FORMATIONS ENCOUNTERED	FROM	TO
<i>clay</i>	<i>0</i>	<i>20</i>
<i>sand & gravel</i>	<i>20</i>	<i>60</i>
<i>clay</i>	<i>60</i>	<i>90</i>
<i>sand & gravel</i>	<i>90</i>	<i>120</i>
<i>sand</i>	<i>120</i>	<i>150</i>
<i>course sand</i>	<i>150</i>	<i>162</i>

RECEIVED
MAY 07 2003
BY: OLWR

Top of Lap Pipe or Reduction in Casing
FEET IF TELESCOPED OR MORE THAN ONE SCREEN: USE BACK PAGE

WELL DATA

Well Depth *162* Casing Diameter (In.) *4"* Casing Length (Ft.) *150*

Type of Casing *PVC* Hole Depth *162'* Depth to Static Water Level *100'*

TYPE OF COMPLETION: (Circle One or More):
 Gravel Packed, Underreamed, Telescoped,
 Natural Development, Open Hole, Other
(Describe)

WELL GROUTED TO A DEPTH OF 10 FEET
Type Grout (circle one): Cement, Bentonite, *MB*

SCREEN DATA

Diameter - Inches *4"* Length - Feet *10'* Slot Size - Inches *.012*

Screen Type *PVC* Depth to Bottom - Feet *162'*

I certify that the well was drilled, constructed and completed in accordance with all applicable Requirements of the Mississippi Department of Environmental Quality and/or the Mississippi Department of Health regulations and state laws.


Brian Fitzgerald *029*
Signature of Licensed Driller and License No.

50-5-03
Date

Additional Information Required On Back

If well telescopes please sketch and show depths.

GROUND LEVEL

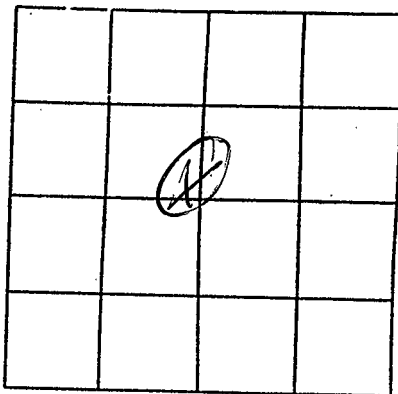

SECTION 24

Please indicate well location X.

Pump Capacity (GPM)	No. of Stages	Setting Depth
<u>20</u>	<u>8</u>	<u>130'</u> FT.

PUMP TEST

Well yielded _____ GPM with
a drawdown of _____ ft.
after _____ hours of pumping

LOG DATA

TYPE OF LOG RUN (Circle One): No Log Run, Electric, Gamma Ray, Density, Sonic, Neutron, Other (Describe) _____

Name of Organization Running Log _____

GEOLOGIC DATA (Office Use Only)

Surface Elev.	Geologic Unit	Unit Thickness	Depth to Top
Subs. SWL	Date	Analysis	Aquifer Test

Driller's Remarks

If more than one screen, show location of each on sketch.