

F *2002*

WATER WELL DRILLERS LOG


Date: *Oct 16*, 19*64*, Driller: *[Signature]* County *Walthall*
 (Name)

(1) Owner of Land: *Mrs Kenneth Gray*
 (Name)
L. Hartman Miss
 (Address)
 (2) Location: ¹/₄, ¹/₄, Sec. 24 2-11
 T R
0 miles of
 (distance) (direction) (Nearest Town)
 (3) Topography: _____
 (Hilly) (Flat) (Level)
 (4) Purpose of Well: *Domestic*
 (Domestic Irrigation
 Municipal, Industrial, Other)

Description & Color of Materials Sand, Clay, Red Clay, Shell, etc.	Thick- ness Feet	Depth Feet
<i>95 Red sand clay</i>		
<i>90 Shell</i>		
<i>90 Red sand</i>		

Information upon completion of well:

(1) Diameter 4 inches.
 (2) Total Depth 130 feet.
 (3) Water Level 100 feet below top of ground.
 (4) Cased to 144, Size 4
 (5) Screen: Size 4, Length 60 feet
 (6) Were any formations sealed against pollution?
 _____ yes, 0 no.
 If YES depth of formation _____
 Why _____
 Drillers Remarks: _____

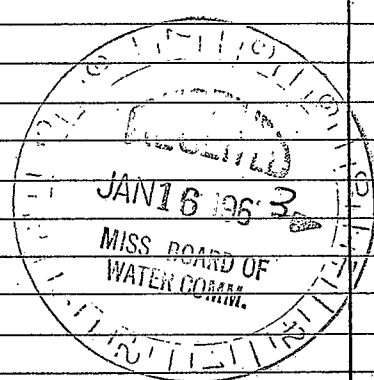

Well No.

(Use Back Side)

