

# WATER WELL DRILLERS LOG

F<sup>2004</sup>

Date: 4-8, 1963, Driller: S.S. Rouse County North

(Name)

- (1) Owner of Land: Osca Rigatt  
(Name)  
Zylbertson Miss  
(Address) 14 2-11
- (2) Location: 1/4, 1/4, Sec. T R,  
9 miles, of 9,  
(distance) (direction) (Nearest Town)
- (3) Topography:         
(Hilly) (Flat) (Level)
- (4) Purpose of Well: Farm  
(Domestic Irrigation Municipal, Industrial, Other)

Description & Color of Materials  
Sand, Clay, Red Clay, Shell, etc.

Thick-  
ness  
Feet

Depth  
Feet

80 feet Red  
clay and sand  
30 ft Pink clay  
4 ft water sand


**Information upon completion of well:**

- (1) Diameter 4 inches.
- (2) Total Depth 144 feet.
- (3) Water Level 105 feet below top of ground.
- (4) Cased to 148, Size 4.
- (5) Screen: Size 4, Length 6.
- (6) Were any formations sealed against pollution?  
       yes, X no.

If YES depth of formation       

Why       

Drillers Remarks:       

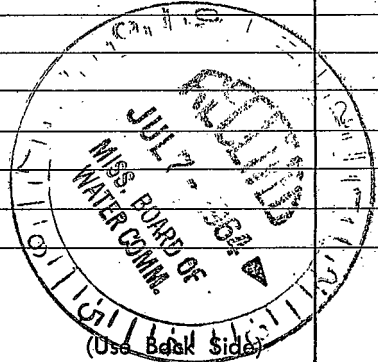

(Use Back Side)

Well No.

