

WALTHALL
F 2002
11-20-75

MISSISSIPPI
 BOARD OF WATER COMMISSIONERS
 416 North State Street
 Jackson, Mississippi 39201

WATER WELL DRILLERS LOG

Nov. 20 19 *75* *Rever Well Ser* *Walthall*
 date well completed firm name county well located

LANDOWNER:
Mr. Arroy Jiggott
Style Tower
 (mailing address)

description of formations encountered	from	to
<i>Red Clay</i>	<i>0</i>	<i>15</i>
<i>Sand & gravel</i>	<i>15</i>	<i>40</i>
<i>Chalk</i>	<i>40</i>	<i>170</i>
<i>Coarse Sand</i>	<i>170</i>	<i>205</i>

WELL LOCATION:
 sec. *13* T. *2* N. R. *11* E
in Knado miles *—* of *Knado*
 (distance) (direction) (nearest town)

WELL PURPOSE: *Home*
 (home, irrigation, municipal, industrial)

- WELL COMPLETION DATA:
- (1) diameter (inches) *4"*
 - (2) total depth (feet) *205*
 - (3) static water level (feet) *105* below top of ground.
 - (4) casing *Plastic bottom* (material) (depth)
 - 1* If telescope see back. (size)
 - (5) screen *6"* (length) *199* (depth to top)
 - 4"* (size) *plastic* (material)
 - (6) pump *3/8 Sub* (HP) *12* (yield gpm)
 - elect* (type power)
 - (7) electric log *no* (yes or no)
 - (organization running log)

(8) how well bottom plugged
W/air plug


DRILLERS REMARKS:
all plastic put by
lighting

RECEIVED
 JAN 23 1976

MISS. BUREAU OF WATER RESOURCES

If well telescopes please sketch and show depths.

GROUND LEVEL

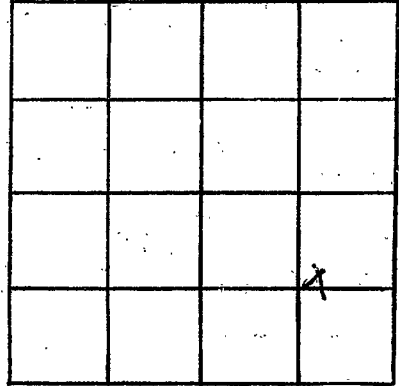

SECTION 13

Please indicate well location X.

ADDITIONAL INFORMATION

If more than one screen, show locations of each on sketch.