

Walthall
F 3009
5/18/76

MISSISSIPPI
 BOARD OF WATER COMMISSIONERS
 416 North State Street
 Jackson, Mississippi 39201

WATER WELL DRILLERS LOG

May 18 1976 Peems Walter Walthall
 date well completed firm name county well located

LANDOWNER:
Clinton Elgaly
R. F. D. Jylitoma
 (mailing address)

description of formations encountered	depth	
	from	to
<u>Red Clay</u>	<u>0</u>	<u>0.2</u>
<u>Red Sand</u>	<u>2.5</u>	<u>4.0</u>
<u>sand gravel</u>	<u>4.0</u>	<u>6.5</u>
<u>pink Chalk</u>	<u>6.5</u>	<u>8.0</u>
<u>hard pea gravel</u>	<u>8.0</u>	<u>9.5</u>

WELL LOCATION:
 sec. 17 T. 2 N. R. 11 E.
2 1/2 miles E-NE of Jylitoma
 (distance) (direction) (nearest town)

WELL PURPOSE: house
 (home, irrigation, municipal, industrial)

WELL COMPLETION DATA:

(1) diameter (inches) 4"

(2) total depth (feet) 9.5'

(3) static water level (feet) 75 below above top of ground.

(4) casing plastic bottom
 (material) (depth)

(size) If telescope see back.

(5) screen 6" 8.9'
 (length) (depth to top)

4" plastic
 (size) (material)

(6) pump 1/2 Sub 1.0
 (HP) (yield gpm)

slat
 (type power)

(7) electric log no
 (yes or no)

(organization running log)

(8) how well bottom plugged:
wooden plug

DRILLERS REMARKS:
new house site


RECEIVED

AUG 20 1976

MISS. BD. OF WATER COMM.

If well telescopes please sketch and show depths.

GROUND LEVEL

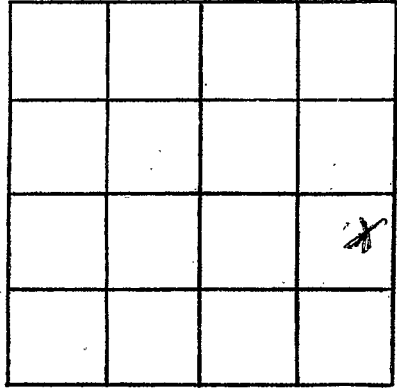

SECTION 17

Please indicate well location X.

ADDITIONAL INFORMATION

If more than one screen,
show locations of each on sketch.