

WALTHALL  
 F 2010  
 5/24/76

MISSISSIPPI  
 BOARD OF WATER COMMISSIONERS  
 416 North State Street  
 Jackson, Mississippi 39201

WATER WELL DRILLERS LOG

May 24 1976 Reverend Miller Walthall  
 date well completed firm name county well located

LANDOWNER:  
Albert Lawrence Jobe  
R. F. J. Joplin  
 (mailing address)

description of formations encountered	from	to
clay	0	6
sand & gravel	6	18
blue chalk	18	26
gravel & sand	26	38

WELL LOCATION:  
 sec. 18 T. 2 N. R. 4 E  
1 miles north of Joplin  
 (distance) (direction) (nearest town)

WELL PURPOSE: home  
 (home, irrigation, municipal, industrial)

WELL COMPLETION DATA:  
 (1) diameter (inches) 4"  
 (2) total depth (feet) 38'  
 (3) static water level (feet) 10 below top of ground.  
 (4) casing plastic bottom  
 (material) (depth)  
 (size) if telescope see back.  
 (5) screen 6' 32  
 (length) (depth to top)  
4" plastic  
 (size) (material)  
 (6) pump 1/2 6  
 (HP) (yield gpm)  
elect  
 (type power)  
 (7) electric log no  
 (yes or no)  
 (organization running log)

(8) how well bottom plugged  
wooden plug

DRILLERS REMARKS:  
no remarks


RECEIVED

AUG 20 1976

MISS. BD. OF WATER COMM

If well telescopes please sketch and show depths.

GROUND LEVEL

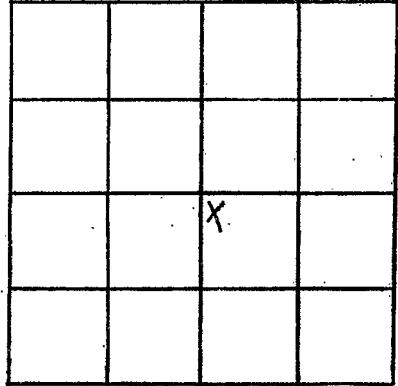

SECTION 18

Please indicate well location X.

ADDITIONAL INFORMATION

If more than one screen, show locations of each on sketch.