

WALTHALL  
 F 2011  
 11/76

MISSISSIPPI  
 BOARD OF WATER COMMISSIONERS  
 416 North State Street  
 Jackson, Mississippi 39201

WATER WELL DRILLERS LOG

JAN. 1976 F. B. SHEPARD WALTHALL  
 date well completed firm name county well located

LANDOWNER:

JESSIE LEE STEPHNEY JR.  
 TYLERTOWN, MISS.  
 (mailing address)

description of formations encountered

from to

SANDY RED  
 CLAY STREAKS 9 110'  
 GRAVEL & SAND 110 142'

WELL LOCATION:

sec. 12 T 2 N R 11 E  
 S W  
 6 miles NE TYLERTOWN  
 (distance) (direction) (nearest town)

WELL PURPOSE:

(home irrigation, municipal, industrial)

WELL COMPLETION DATA:

- (1) diameter (inches) 4"
- (2) total depth (feet) 142'
- (3) static water level (feet) 90' below above top of ground.
- (4) casing cpl. 132'  
 (material) (depth)  
 4" If telescope see back.  
 (size)
- (5) screen 10'  
 (length) (depth to top)  
 4" pl.  
 (size) (material)
- (6) pump 1/2 HP 14  
 (HP) (yield gpm)  
 elec.  
 (type power)
- (7) electric log (yes or no) (no)

(organization running log)

(8) how well bottom plugged B.W.V.

DRILLERS REMARKS:


RECEIVED

OCT 18 1976

MISS. BD. OF WATER COMMISSIONERS

If well telescopes please sketch and show depths.

GROUND LEVEL

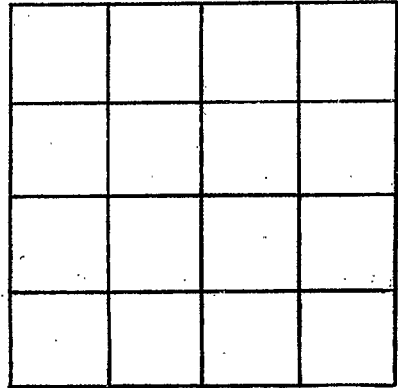

SECTION \_\_\_\_\_

Please indicate well location X.

ADDITIONAL INFORMATION

If more than one screen,  
show locations of each on sketch.