

Walthall
 F 2012
 Jan. 1976

MISSISSIPPI
 BOARD OF WATER COMMISSIONERS
 416 North State Street
 Jackson, Mississippi 39201

WATER WELL DRILLERS LOG

JAN 1976 E. B. SHERBARD WALTHALL
 date well completed firm name county well located

LANDOWNER:

WILBERT RATLIFF

Rt. 2 - TYLERTOWN, Miss
 (mailing address)

description of formations
 encountered

from to

RED SAND CLAY	0	70
CLAY CLAY	70	110
COARSE SAND & GRAVEL	110	140

WELL LOCATION:

sec. 12 T 2 N R 11 E
 S W
 6 miles NE TYLERTOWN
 (distance) (direction) (nearest town)

WELL PURPOSE:

(home, irrigation, municipal, industrial)

WELL COMPLETION DATA:

- (1) diameter (inches) 2"
- (2) total depth (feet) 140'
- (3) static water level (feet) 60' ^{below} / _{above} top of ground.
- (4) casing pl. 135'
 (material) (depth)
 2" if telescope see back.
 (size)
- (5) screen 5'
 (length) (depth to top)
 2" pl.
 (size) (material)
- (6) pump 1 (HP) 7 (yield gpm)
 elec.
 (type power)
- (7) electric log (yes or no) (no)

(organization running log)

(8) how well bottom plugged B/W

DRILLERS REMARKS:


RECEIVED

OCT 18 1976

MISS. BD. OF WATER COMM

If well telescopes please sketch and show depths.

GROUND LEVEL

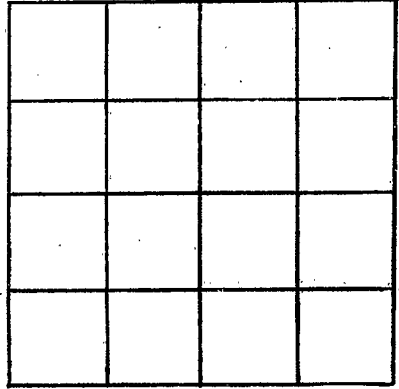

SECTION _____

Please indicate well location X.

ADDITIONAL INFORMATION

If more than one screen, show locations of each on sketch.