

Walthall
 F 2013
 2/76

MISSISSIPPI
 BOARD OF WATER COMMISSIONERS
 416 North State Street
 Jackson, Mississippi 39201

WATER WELL DRILLERS LOG

Feb 1976 E.B. Sheppard, Walthall
 date well completed firm name county well located

LANDOWNER: Ida Mae Lee
 description of formations encountered: GRAVEL BED, CLAY, SAND & PEA GR.
 from 0 to 60' / 60' to 88'
 290 S. Walthall, Miss. (mailing address)

WELL LOCATION:
 sec. 6 T 2 N R 11 E S W
 3 miles N Walthall
 (distance) (direction) (nearest town)

WELL PURPOSE:
 (home, irrigation, municipal, industrial)

- WELL COMPLETION DATA:
- (1) diameter (inches) 2"
 - (2) total depth (feet) 88'
 - (3) static water level (feet) 70' below top of ground.
 - (4) casing pl. 83' (material) (depth)
 2" If telescope see back. (size)
 - (5) screen 5' (length) (depth to top)
 2" pl. (size) (material)
 - (6) pump 1 (HP) 6 (yield gpm)
 elec. (type power)
 - (7) electric log (yes or no) (no)
 - (8) how well bottom plugged B/W


DRILLERS REMARKS:

RECEIVED
 OCT 18 1976

MISS. BD. OF WATER COMM.

If well telescopes please sketch and show depths.

GROUND LEVEL

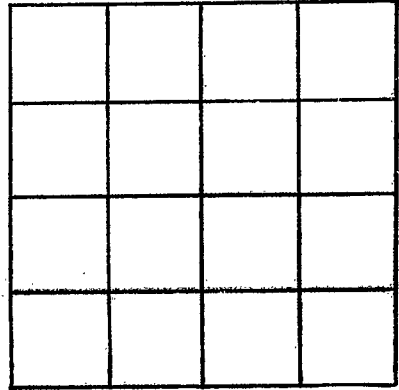

SECTION _____

Please indicate well location X.

ADDITIONAL INFORMATION

If more than one screen, show locations of each on sketch.