

WALTHALL  
 F 2014  
 5/13/77

MISSISSIPPI  
 BOARD OF WATER COMMISSIONERS  
 416 North State Street  
 Jackson, Mississippi 39201

(42)

WATER WELL DRILLERS LOG

May 13, 1977 Rever Well Co. Walthall  
 date well completed firm name county well located

LANDOWNER:  
Ray Holmes  
RT. Tipton  
 (mailing address)

description of formations encountered	from	to
<u>sandy clay</u>	<u>0</u>	<u>16</u>
<u>red sand</u>	<u>16</u>	<u>70</u>
<u>small gravel &amp; sand</u>	<u>70</u>	<u>90</u>

WELL LOCATION:  
 sec. 24 T. 2 N R. 11 E  
5 miles east of Tipton  
 (distance) (direction) (nearest town)

WELL PURPOSE: Domestic  
 (home, irrigation, municipal, industrial)

WELL COMPLETION DATA:  
 (1) diameter (inches) 4"  
 (2) total depth (feet) 90'  
 (3) static water level (feet) 65' below above top of ground  
 (4) casing plastic bottom  
 (material) (depth)  
 (size) if telescope see back.  
 (5) screen 5' 85'  
 (length) (depth to top)  
4" plastic  
 (size) (material)  
 (6) pump 1/2 hp 10  
 (HP) (yield gpm)  
220v  
 (type power)  
 (7) electric log no  
 (yes or no)  
 (organization running log)

(8) how well bottom plugged  
no screen plug


DRILLERS REMARKS:  
 \_\_\_\_\_

**RECEIVED**  
 JUN 21 1977

MISS. BU. OF WATER COMMISSIONERS

If well telescopes please sketch and show depths.

GROUND LEVEL

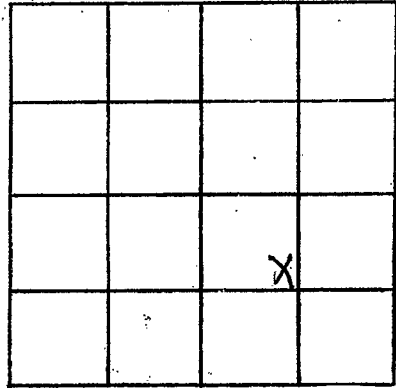

SECTION 24

Please indicate well location X.

ADDITIONAL INFORMATION

If more than one screen,  
show locations of each on sketch.