

WALTHALL
F 2015
May 21, 1977

MISSISSIPPI
 BOARD OF WATER COMMISSIONERS
 416 North State Street
 Jackson, Mississippi 39201

47

WATER WELL DRILLERS LOG

May 21 1977 Reverend Walthall
 date well completed firm name county well located

LANDOWNER:
Mr. Walter Pigott
Attn: Iy litown 39667
 (mailing address)

description of formations encountered	from	to
Clay	0	12
sand of gravel	12	26
pebbles sand	26	64
sand rock	64	65
Coarse sand	65	75

WELL LOCATION:
 sec. 6 T. 2 N R. 4 E
 S 8 CW
2 1/2 miles north of Iy litown
 (distance) (direction) (nearest town)

WELL PURPOSE: Trailer
 (home, irrigation, municipal, industrial)

WELL COMPLETION DATA:
 (1) diameter (inches) 4"
 (2) total depth (feet) 75
 (3) static water level (feet) 12 below above top of ground.
 (4) casing plastic bottom
 (material) (depth)
 (size) if telescope see back.
 (5) screen 5' 70
 (length) (depth to top)
1/2" plastic
 (size) (material)
 (6) pump 1/2 HP 6
 (HP) (yield gpm)
elect
 (type power)
 (7) electric log NO
 (yes or no)
 (organization running log)


(8) how well bottom plugged
wooden plug
 DRILLERS REMARKS:
no present well
no location

RECEIVED
 JUN 21 1977

MISS. BU. OF WATER COMMISSIONERS

If well telescopes please sketch and show depths.

GROUND LEVEL

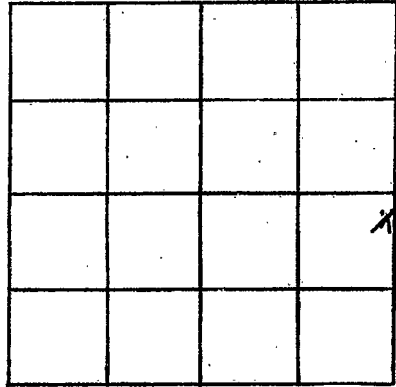

SECTION 6

Please indicate well location X.

ADDITIONAL INFORMATION

If more than one screen, show locations of each on sketch.