

Walshall

F 2014

6-16-77

MISSISSIPPI BOARD OF WATER COMMISSIONERS  
416 North State Street  
Jackson, Mississippi 39201

WATER WELL DRILLERS LOG

6-16 1977  
date well completed

134 Fitzgerald Well Serv  
firm name

Walshall  
county well located

LANDOWNER:

Frank W. Hittington

R.R. Tylister  
(mailing address)

description of formations encountered

from

to

Red clay  
course full of gravel

5

22

20

47

WELL LOCATION:

sec. 6 T 2 N R 11 E  
S W  
4 miles N of Tylister  
(distance) (direction) (nearest town)

WELL PURPOSE:

Home  
(home, irrigation, municipal, industrial)

WELL COMPLETION DATA:

- (1) diameter (inches) 4
- (2) total depth (feet) 47
- (3) static water level (feet) 15 below top of ground.
- (4) casing PVC, 39, (material) (depth)  
4 (size) if telescope see back.
- (5) screen 8, 39, (length) (depth to top)  
4 (size) PVC (material)
- (6) pump 1/2, 10, (HP) (yield gpm)  
Alec (type power)
- (7) electric log Yes (yes or no)  
(organization running log)
- (8) how well bottom plugged Seal block


DRILLERS REMARKS:

RECEIVED

JUN 29 1977

If well telescopes please sketch and show depths.

GROUND LEVEL

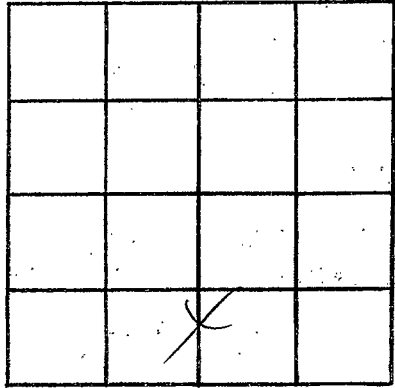

SECTION 6

Please indicate well location X.

ADDITIONAL INFORMATION

If more than one screen,  
show locations of each on sketch.