

WALTHALL
 F 2017
 9/12/77

MISSISSIPPI
 BOARD OF WATER COMMISSIONERS
 416 North State Street
 Jackson, Mississippi 39201

(121)

WATER WELL DRILLERS LOG

9-12 1977 Revere Miller Walthall
 date well completed firm name county well located

LANDOWNER:
George Shaemakes
Rt. 1, Syleston
 (mailing address)

description of formations encountered	from	to
clay	0	8
sand channel	8	23
hard white chalk	23	95
coarse white sand	95	120

WELL LOCATION:
 sec. 18 T. 2 N R. 11 E
1 1/2 miles North of Syleston
 (distance) (direction) (nearest town)

WELL PURPOSE: home
 (home, irrigation, municipal, industrial)

- WELL COMPLETION DATA:
- (1) diameter (inches) 4"
 - (2) total depth (feet) 120
 - (3) static water level (feet) 40 below top of ground.
 - (4) casing plastic, 110 below top of ground.
 (material) (depth)
 - 1/2 if telescope see back.
 (size)
 - (5) screen 5', 115'
 (length) (depth to top)
 - 4", plastic
 (size) (material)
 - (6) pump 3/4 HP, 8 yield gpm
split
 (type power)
 - (7) electric log no
 (yes or no)
- (organization running log)

(8) how well bottom plugged
no sand plug


DRILLERS REMARKS:
old 2" well
went east

RECEIVED

FEB 21 1978

If well telescopes please sketch and show depths.

GROUND LEVEL

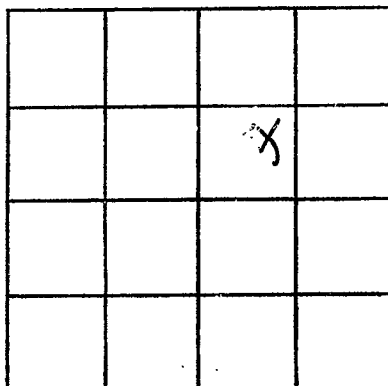

SECTION 18

Please indicate well location X.

ADDITIONAL INFORMATION

If more than one screen, show locations of each on sketch.