

WALTHALL  
 F 2018  
 9-20-77

MISSISSIPPI  
 BOARD OF WATER COMMISSIONERS  
 416 North State Street  
 Jackson, Mississippi 39201

WATER WELL DRILLERS LOG

9-20 1977 Fitzgerald Well Service Walthall  
 date well completed firm name county well located


LANDOWNER:	description of formations encountered	from	to
<u>Alexander Reading</u>			
<u>P.O. Lytle town, Miss.</u> (mailing address)	<u>Red clay</u> <u>Red sand</u> <u>Coarse sand &amp; gravel</u>	<u>0</u> <u>20</u> <u>105</u>	<u>20</u> <u>105</u> <u>120</u>
WELL LOCATION: sec. <u>7</u> T. <u>20</u> N. S. R. <u>11</u> E. W. <u>2</u> miles <u>N</u> of <u>Lytle town</u> (distance) (direction) (nearest town)			
WELL PURPOSE: (home, irrigation, municipal, industrial) <u>Home</u>			
WELL COMPLETION DATA: (1) diameter (inches) <u>4</u> (2) total depth (feet) <u>120</u> (3) static water level (feet) <u>55</u> below above top of ground. (4) casing <u>POC</u> , <u>112</u> , (material) (depth) <u>4</u> if telescope see back. (size) (5) screen <u>8</u> , <u>112</u> (length) (depth to top) <u>4</u> , <u>POC</u> (size) (material) (6) pump <u>1/2</u> , <u>10</u> (HP) (yield gpm) <u>elec</u> (type power) (7) electric log <u>No</u> (yes or no) (organization running log) (8) how well bottom plugged <u>Sand shell</u>			
DRILLERS REMARKS:			

RECEIVED  
 OCT 30 1977

MISS. BD. OF WATER COMMISSIONERS

If well telescopes please sketch and show depths.

GROUND LEVEL

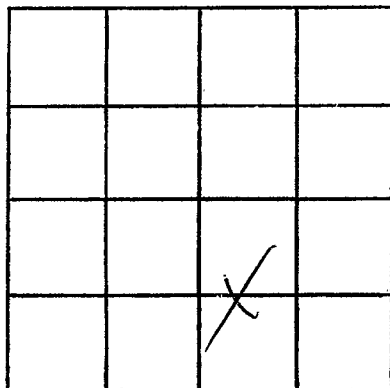

SECTION 7

Please indicate well location X.

ADDITIONAL INFORMATION

If more than one screen,  
show locations of each on sketch.