

WALTHALL  
F 2009  
9/15/77

MISSISSIPPI  
BOARD OF WATER COMMISSIONERS  
416 North State Street  
Jackson, Mississippi 39201

124

WATER WELL DRILLERS LOG

9-15 1977 Reuser Well Service Walthall  
date well completed firm name county well located

LANDOWNER:  
Miss. Clois Sartin  
P.O. Tylertown  
(mailing address)

description of formations encountered	from	to
<u>Clay</u>	<u>0</u>	<u>12</u>
<u>sand &amp; gravel</u>	<u>19</u>	<u>20</u>
<u>White Chalk</u>	<u>20</u>	<u>75</u>
<u>Coarse sand</u>	<u>75</u>	<u>103</u>

WELL LOCATION:  
sec. 18 T-2 N R-11 E  
1/2 miles north of Tylertown  
(distance) (direction) (nearest town)

WELL PURPOSE: Home  
(home, irrigation, municipal, industrial)

WELL COMPLETION DATA:  
(1) diameter (inches) 4"  
(2) total depth (feet) 103  
(3) static water level (feet) 40 <sup>below</sup> ~~above~~ top of ground.  
(4) casing plastic, bottom  
(material) (depth)  
no if telescope see back.  
(size)  
(5) screen 5' 97'  
(length) (depth to top)  
4" plastic  
(size) (material)  
(6) pump 1/2 HP 2  
(HP) (yield gpm)  
shot  
(type power)  
(7) electric log no  
(yes or no)  
no  
(organization running log)

(8) how well bottom plugged:  
wooden plug


DRILLERS REMARKS:  
no

RECEIVED  
FEB 21 1978

MISS. BD. OF WATER COMM.

If well telescopes please sketch and show depths.

GROUND LEVEL

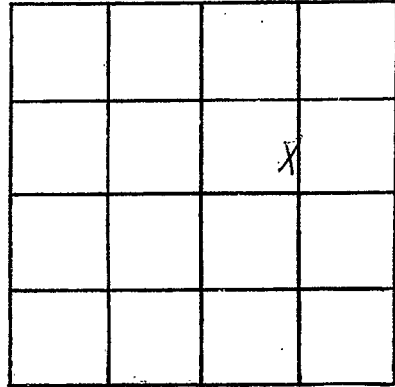

SECTION 18

Please indicate well location X.

ADDITIONAL INFORMATION

If more than one screen,  
show locations of each on sketch.