

WALTHALL

2000 F

4-17-78

MISSISSIPPI BOARD OF WATER COMMISSIONERS  
416 North State Street  
Jackson, Mississippi 39201

WATER WELL DRILLERS LOG

4-17 1978  
date well completed

Fitzgerald  
firm name

Walthall  
county well located

LANDOWNER:

Fredy Baskin  
R.R. Tylertown  
(mailing address)

description of formations encountered

from to

Red clay	0	20
Red sand	20	40
Blue chalk	40	150
Case fault zone	150	160

WELL LOCATION:

sec. 7-T-2 N R-11-E  
S W  
2 miles N of Tylertown  
(distance) (direction) (nearest town)

WELL PURPOSE:

Home  
(home, irrigation, municipal, industrial)

WELL COMPLETION DATA:

- (1) diameter (inches) 4
- (2) total depth (feet) 160
- (3) static water level (feet) 50 above top of ground.
- (4) casing PVC, 150,  
(material) (depth)  
4 if telescope see back.  
(size)
- (5) screen 8, 152  
(length) (depth to top)  
4, PVC  
(size) (material)
- (6) pump 1/2 10  
(HP) (yield gpm)  
elc  
(type power)
- (7) electric log no  
(yes or no)  
(organization running log)
- (8) how well bottom plugged sealed


DRILLERS REMARKS:

RECEIVED  
APR 27 1978

MISS. BD. OF WATER COMMISSIONERS

If well telescopes please sketch and show depths.

GROUND LEVEL

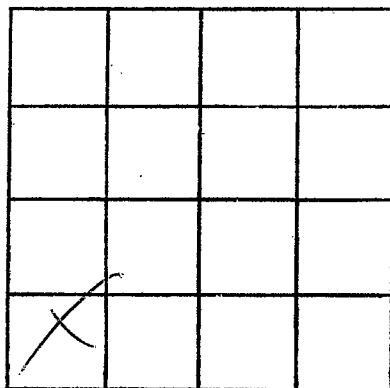

SECTION 7

Please indicate well location X.

ADDITIONAL INFORMATION

If more than one screen, show locations of each on sketch.