

WALTHALL
 F 2000
 6/5/78

MISSISSIPPI
 BOARD OF WATER COMMISSIONERS
 416 North State Street
 Jackson, Mississippi 39201

WATER WELL DRILLERS LOG

6-05-78 date well completed
~~Johnson Water Well Serv.~~ firm name
 Anthony Woodward Bell Co. county well located
 Walthall

LANDOWNER: Herchel Stogner
 Rt. 7
 Tyler town, Miss.
 (mailing address)


description of formations encountered	from	to
Red Clay	0	45'
Sand & gravel	45	76'
Blue clay	76	95'
Gravel & sand	95	110'

WELL LOCATION:
 sec. 27 T. 2 N R. 11 E
2 1/2 miles E of Tyler town
 (distance) (direction) (nearest town)

WELL PURPOSE: Restaurant
 (home, irrigation, municipal, industrial)

- WELL COMPLETION DATA:
- (1) diameter (inches) 4"
 - (2) total depth (feet) 110
 - (3) static water level (feet) 55 below top of ground.
 - (4) casing PVC (material) 100' (depth)
4" (size) if telescope see back.
 - (5) screen 10' (length) 100' (depth to top)
4" x .014 (size) PVC (material)
 - (6) pump 1/2 (HP) 8 (yield gpm)
230V AC (type power)
 - (7) electric log NO (yes or no)
- (organization running log)
- (8) how well bottom plugged Flush
Type (SW)


DRILLERS REMARKS:

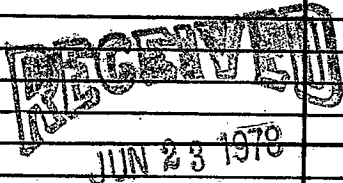

MISS. BD. OF WATER COMM

If well telescopes please sketch and show depths.

GROUND LEVEL

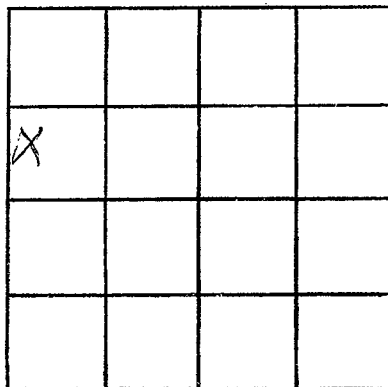

SECTION 27

Please indicate well location X.

ADDITIONAL INFORMATION

If more than one screen,
show locations of each on sketch.