

WALTHALL
 F2022
 7-13-78

MISSISSIPPI
 BOARD OF WATER COMMISSIONERS
 416 North State Street
 Jackson, Mississippi 39201

WATER WELL DRILLERS LOG

7-13 1978 *Fitzhugh Well Serv* *Walthall*
 date well completed firm name county well located

LANDOWNER:
 E.C. McNeil
 R.R. Fitzhugh, ms
 (mailing address)

WELL LOCATION:
 sec. 6 T. 2 N R. 11 E
 S W
2 miles N of Fitzhugh
 (distance) (direction) (nearest town)

WELL PURPOSE:
 Home
 (home, irrigation, municipal, industrial)

description of formations encountered	from	to
Red Clay	0	20
Red sand	20	80
Red chalk	80	100
Red sand	100	120
Coarse sandstone	120	130

WELL COMPLETION DATA:

(1) diameter (inches) 4

(2) total depth (feet) 130

(3) static water level (feet) 50 below above top of ground.

(4) casing PVC 122
 (material) (depth)
4 if telescope see back.
 (size)

(5) screen 8 122
 (length) (depth to top)
4 PVC
 (size) (material)

(6) pump 1/2 10
 (HP) (yield gpm)
Electric
 (type power)

(7) electric log no
 (yes or no)


(8) how well bottom plugged Sand blk
 (organization running log)

DRILLERS REMARKS:

RECEIVED
 AUG 14 1978
 MISS. BD. OF WATER COMM

If well telescopes please sketch and show depths.

GROUND LEVEL

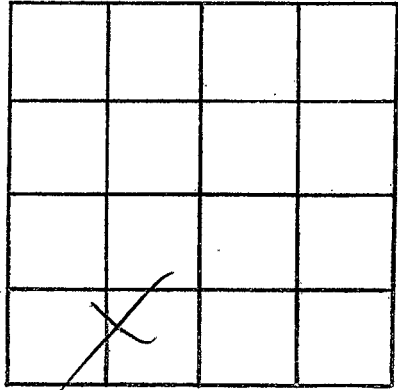

SECTION 6

Please indicate well location X.

ADDITIONAL INFORMATION

If more than one screen,
show locations of each on sketch.