

WALTHALL  
 F 2024  
 9-20-78

MISSISSIPPI  
 BOARD OF WATER COMMISSIONERS  
 416 North State Street  
 Jackson, Mississippi 39201

WATER WELL DRILLERS LOG

9-20 19 78 Fitzell Well Serv Walthall  
 date well completed firm name county well located

LANDOWNER:  
Jimmy Seaves  
RR. 1  
 (mailing address)

description of formations encountered	from	to
<u>Red clay</u>	<u>0</u>	<u>20</u>
<u>Red clay</u>	<u>20</u>	<u>115</u>
<u>Coarse sand &amp; gravel</u>	<u>115</u>	<u>128</u>

WELL LOCATION:  
 sec. 24 T 2 N R 11 E  
                   S                    W  
5 1/2 miles E of Flycatch  
 (distance) (direction) (nearest town)

WELL PURPOSE: Flow  
 (home, irrigation, municipal, industrial)

- WELL COMPLETION DATA:
- (1) diameter (inches) 4
  - (2) total depth (feet) 128
  - (3) static water level (feet) 86 below above top of ground.
  - (4) casing PVC 120  
 (material) (depth)  
1 if telescope see back.  
 (size)
  - (5) screen 8 120  
 (length) (depth to top)  
1/2 (size) PVC (material)
  - (6) pump 1/2 10  
 (HP) (yield gpm)  
Electric (type power)
  - (7) electric log no  
 (yes or no)  
no (organization running log)
  - (8) how well bottom plugged Sand 1/2 lb


DRILLERS REMARKS:

RECEIVED  
 OCT 4 1978

MISS. BD. OF WATER COMMISSIONERS

If well telescopes please sketch and show depths.

GROUND LEVEL

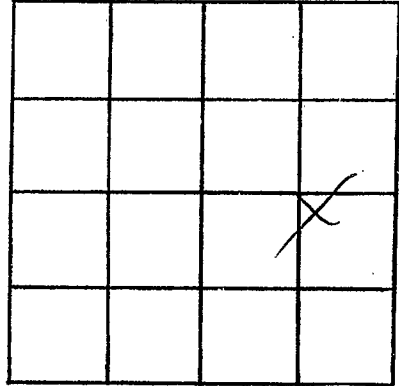

SECTION 24

Please indicate well location X.

ADDITIONAL INFORMATION

If more than one screen, show locations of each on sketch.