

WALTHALL

F 2027

10-27-78

MISSISSIPPI  
 BOARD OF WATER COMMISSIONERS  
 416 North State Street  
 Jackson, Mississippi 39201

WATER WELL DRILLERS LOG

WALTHALL

10-27-78  
date well completed

1978 F. H. Swellwell Serv  
firm name

county well located

LANDOWNER:

Rudolph Bullock

P.O. Telatown  
(mailing address)

WELL LOCATION:

sec. 1 T 2 N R 11 E  
                   S                   W  
7 miles E of Telatown  
 (distance) (direction) (nearest town)

WELL PURPOSE: Home  
(home, irrigation, municipal, industrial)

WELL COMPLETION DATA:

- (1) diameter (inches) 4
- (2) total depth (feet) 149
- (3) static water level (feet) 115 below  
top of ground.
- (4) casing POC, 141,  
(material) (depth)  
4 if telescope see back.  
(size)
- (5) screen 8, 141  
(length) (depth to top)  
4, POC  
(size) (material)
- (6) pump 1/2, 10  
(HP) (yield gpm)  
Elco  
(type power)
- (7) electric log no  
(yes or no)

(organization running log)

(8) how well bottom plugged Seal off

description of formations encountered

from

to

Red clay	0	20
Red sand	20	90
Red gravel	90	135
Coarse sandstone	135	149


DRILLERS REMARKS:

RECEIVED  
DEC-7 1978

MISS. BD. OF WATER COMM

If well telescopes please sketch and show depths.

GROUND LEVEL

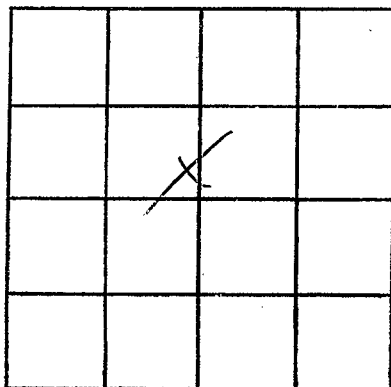

SECTION 1

Please indicate well location X.

ADDITIONAL INFORMATION

If more than one screen, show locations of each on sketch.