

WALTHALL

F 2028

10-26-78

MISSISSIPPI BOARD OF WATER COMMISSIONERS
416 North State Street
Jackson, Mississippi 39201

WATER WELL DRILLERS LOG

12-26
date well completed

1978 Fitzgerald Well Serv
firm name

Walthall
county well located

LANDOWNER:	description of formations encountered	from	to
Leroy Boyce			
R.R. Luttrell (mailing address)	Red Clay Blue Chalk Coarse sand & gravel	0 20 155	20 155 168
WELL LOCATION:			
sec. <u>5</u> T <u>2</u> N R <u>11</u> E S W <u>3</u> miles <u>N</u> of <u>Luttrell</u> (distance) (direction) (nearest town)			
WELL PURPOSE: (home, irrigation, municipal, industrial)			
WELL COMPLETION DATA:			
(1) diameter (inches) <u>4</u>			
(2) total depth (feet) <u>168</u>			
(3) static water level (feet) <u>+3</u> ^{below} above top of ground.			
(4) casing <u>PVC</u> , <u>160</u> , (material) (depth)			
<u>4</u> if telescope see back. (size)			
(5) screen <u>8</u> , <u>160</u> (length) (depth to top)			
<u>4</u> , <u>PVC</u> (size) (material)			
(6) pump <u>1/2</u> , <u>10</u> (HP) (yield gpm)			
<u>Electric</u> (type power)			
(7) electric log <u>no</u> (yes or no)			
(organization running log)			
(8) how well bottom plugged <u>Sand Shik</u>			
DRILLERS REMARKS:			


RECEIVED

JAN 26 1978

MISS. BD. OF WATER COMM

If well telescopes please sketch and show depths.

GROUND LEVEL

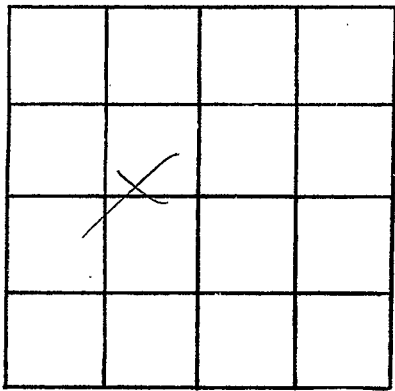

SECTION 5

Please indicate well location X.

ADDITIONAL INFORMATION

Lined area for additional information.

If more than one screen, show locations of each on sketch.