

Walthall
F2030
8-22-79

MISSISSIPPI
 BOARD OF WATER COMMISSIONERS
 416 North State Street
 Jackson, Mississippi 39201

WATER WELL DRILLERS LOG

8-22-1979 date well completed
 29 Fitzgerald Well Service firm name
 Walthall county well located

LANDOWNER:
J. D. Holmes
BB. Tylerborn
 (mailing address)

description of formations encountered	from to	
<u>Red clay</u>	<u>0</u>	<u>20</u>
<u>Red sand</u>	<u>20</u>	<u>45</u>
<u>White chalk</u>	<u>45</u>	<u>120</u>
<u>Coarse sand & gravel</u>	<u>120</u>	<u>132</u>

WELL LOCATION:
 sec. 17 T. 2 N S R. 11 E W
3 miles NE of Fayetteville
 (distance) (direction) (nearest town)

WELL PURPOSE: Home
 (home, irrigation, municipal, industrial)

- WELL COMPLETION DATA:
- (1) diameter (inches) 4
 - (2) total depth (feet) 132
 - (3) static water level (feet) 70 below above top of ground.
 - (4) casing PVC, 124,
 (material) (depth)
4 if telescope see back.
 (size)
 - (5) screen 8, 124
 (length) (depth to top)
4, PVC
 (size) (material)
 - (6) pump 1/2, 10
 (HP) (yield gpm)
Electric
 (type power)
 - (7) electric log no
 (yes or no)
 (organization running log)
 - (8) how well bottom plugged Sand & silt

DRILLERS REMARKS:


Miss. Board of Water Comm.

SEP 12 1979

RECEIVED

If well telescopes please sketch and show depths.

GROUND LEVEL

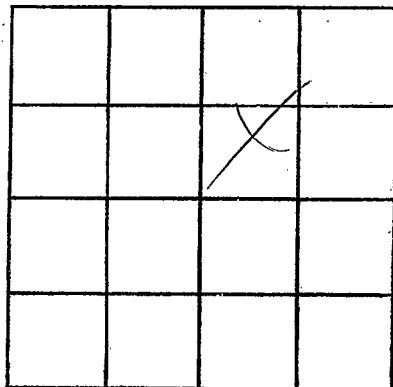

SECTION 17

Please indicate well location X.

ADDITIONAL INFORMATION

If more than one screen, show locations of each on sketch.