

WALTHALL  
 Fa 031  
 12-12-79

MISSISSIPPI  
 BOARD OF WATER COMMISSIONERS  
 416 North State Street  
 Jackson, Mississippi 39201

WATER WELL DRILLERS LOG

12-12  
 date well completed

1979 *Fitzgerald and Son Walthall*  
 firm name

county well located

LANDOWNER:	description of formations encountered	from	to
<i>Eugene Magee</i>			
<i>R.B. Lybenton</i> (mailing address)	<i>Red Clay</i>	<i>0</i>	<i>20</i>
	<i>Red loam</i>	<i>20</i>	<i>120</i>
	<i>Coarse sand &amp; gravel</i>	<i>120</i>	<i>182</i>
<b>WELL LOCATION:</b>			
sec. <u>2</u> T. <u>2</u> (N) S R. <u>11</u> (E) W.			
<u>5</u> miles <u>E.</u> of <u>Lybenton</u> (distance) (direction) (nearest town)			
<b>WELL PURPOSE:</b> (home, irrigation, municipal, industrial)			
<b>WELL COMPLETION DATA:</b>			
(1) diameter (inches) <u>4</u>			
(2) total depth (feet) <u>132</u>			
(3) static water level (feet) <u>115</u> below top of ground.			
(4) casing <u>PVC, 124</u> , (material) (depth), <u>4</u> if telescope see back. (size)			
(5) screen <u>8</u> , <u>124</u> (length) (depth to top) <u>4"</u> , <u>PVC</u> (size) (material)			
(6) pump <u>1/2</u> , <u>10</u> (HP) (yield gpm) <u>Clu</u> (type power)			
(7) electric log <u>no</u> (yes or no) <u>(organization running log)</u>			
(8) how well bottom plugged <u>Sand Shovel</u>			

DEPT. OF NATURAL RESOURCES  
 BUREAU OF LAND & WATER RESOURCES


JAN 31 1980

RECEIVED

DRILLERS REMARKS:

If well telescopes please sketch and show depths.

GROUND LEVEL

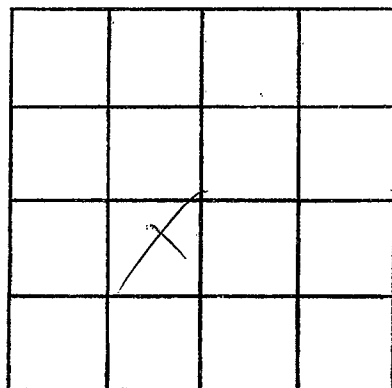

SECTION 2

Please indicate well location X.

ADDITIONAL INFORMATION

If more than one screen,  
show locations of each on sketch.