

Walthall
F 2032

MISSISSIPPI
BOARD OF WATER COMMISSIONERS
416 North State Street
Jackson, Mississippi 39201

5-10-79
May 10
date well completed

WATER WELL DRILLERS LOG

1979 Acumissville Walthall
firm name county well located

LANDOWNER:
Billy Ray Holmes
At 1st Fyhtown
(mailing address)

description of formations encountered	from	to
<u>Red Clay</u>	<u>0</u>	<u>22</u>
<u>Red sand</u>	<u>22</u>	<u>60</u>
<u>Gravel</u>	<u>60</u>	<u>76</u>
<u>Chalky sand</u>	<u>76</u>	<u>105</u>
<u>Small gravel & sand</u>	<u>105</u>	<u>120</u>

WELL LOCATION:
sec. 2 N 11 E
2 1/2 miles E NE of Fyhtown
(distance) (direction) (nearest town)

WELL PURPOSE: Trailer
(home, irrigation, municipal, industrial)

WELL COMPLETION DATA:

(1) diameter (inches) 4"

(2) total depth (feet) 150

(3) static water level (feet) 90 below above top of ground.

(4) casing plastic bottom
(material) (depth)

 If telescope see back.
(size)

(5) screen 5' 115'
(length) (depth to top)

4" plastic
(size) (material)

(6) pump 2 10
(HP) (yield gpm)

chart
(type power)

(7) electric log no
(yes or no)

(organization running log)

(8) how well bottom plugged
wooden plug

DRILLERS REMARKS:


DEPT. OF NATURAL RESOURCES
BUREAU OF LAND & WATER RESOURCES

OCT 19 1979

RECEIVED

If well telescopes please sketch and show depths.

GROUND LEVEL

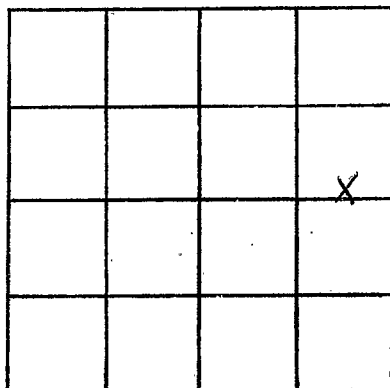

SECTION 16

Please indicate well location X.

ADDITIONAL INFORMATION

If more than one screen, show locations of each on sketch.

915 920
400 420
3:30