

WALTHALL  
 F 2034  
 4-10-79

MISSISSIPPI  
 BOARD OF WATER COMMISSIONERS  
 416 North State Street  
 Jackson, Mississippi 39201

WATER WELL DRILLERS LOG

4-10  
 date well completed

1979 Fitzgerald Well Sew  
 firm name

W. Walthall  
 county well located

LANDOWNER:

Ray Blackwell

R.R. Fultonsville  
 (mailing address)

description of formations encountered

from

to

Red clay	0	20
White chalk	20	160
Coarse sand & gravel	160	178

WELL LOCATION:

sec. 17 T. 20 N. R. 11 E.  
 S W

2 miles NE of Fultonsville  
 (distance) (direction) (nearest town)

WELL PURPOSE:

Home  
 (home, irrigation, municipal, industrial)

WELL COMPLETION DATA:

- (1) diameter (inches) 4
- (2) total depth (feet) 178
- (3) static water level (feet) 75 below above top of ground.
- (4) casing PVC, 170,  
 (material) (depth)  
4 if telescope see back.  
 (size)
- (5) screen 8, 170  
 (length) (depth to top)  
4, PVC  
 (size) (material)
- (6) pump 1/2, 10  
 (HP) (yield gpm)  
electric  
 (type power)
- (7) electric log no  
 (yes or no)  
 (organization running log)
- (8) how well bottom plugged Sand Shale

Miss. Board of Water Commr.


DRILLERS REMARKS:

MAY 30 1979

RECEIVED

If well telescopes please sketch and show depths.

GROUND LEVEL

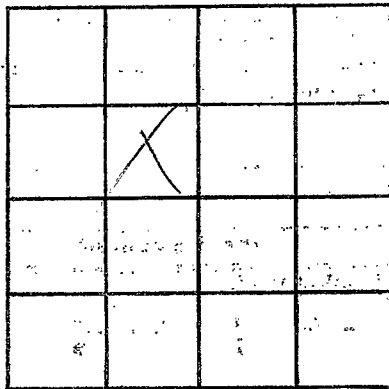

SECTION 17

Please indicate well location X.

ADDITIONAL INFORMATION

If more than one screen,  
show locations of each on sketch.