

WALTHALL

F 2035

1-10-80

MISSISSIPPI
 BOARD OF WATER COMMISSIONERS
 416 North State Street
 Jackson, Mississippi 39201

WATER WELL DRILLERS LOG

1-10

date well completed

1980

Physicist well Serv

firm name

Walthall

county well located

LANDOWNER:

Stanley McNeil

R.R. Lytleton
(mailing address)

description of formations encountered

from

to

Red clay	0	20
Red gravel	20	35
White chalk	35	105
Course sand & gravel	105	128

WELL LOCATION:

sec. 18 T 2 N S R 11 E W

1 miles N of Lytleton
(distance) (direction) (nearest town)

WELL PURPOSE:

(home, irrigation, municipal, industrial)

WELL COMPLETION DATA:

- (1) diameter (inches) 4
- (2) total depth (feet) 128
- (3) static water level (feet) 20 below top of ground.
- (4) casing PVC, 120 (material), (depth)
4 (size) if telescope see back.
- (5) screen 8, 120 (length), (depth to top)
4 (size), PVC (material)
- (6) pump 1/2 (HP), 10 (yield gpm)
elec (type power)
- (7) electric log no (yes or no)
(organization running log)
- (8) how well bottom plugged Sealed block

DEPT. OF NATURAL RESOURCES
BUREAU OF LAND & WATER RESOURCES


DRILLERS REMARKS:

JAN 31 1980

RECEIVED

If well telescopes please sketch and show depths.

GROUND LEVEL

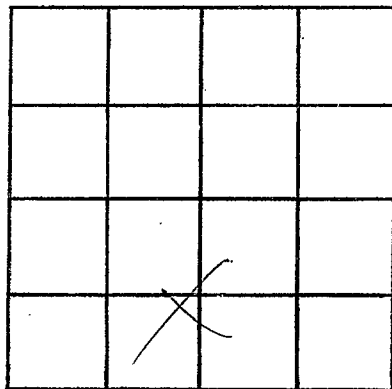

SECTION 18

Please indicate well location X.

ADDITIONAL INFORMATION

If more than one screen,
show locations of each on sketch.