


WALTHALL
 F 2038
 8-14-81

MISSISSIPPI
 BOARD OF WATER COMMISSIONERS
 416 North State Street
 Jackson, Mississippi 39201

WATER WELL DRILLERS LOG


8-14-1981 *Stopper Wells, Walthall*
 date well completed *Stopper Wells* my name county well located

LANDOWNER: <i>C.A. Carr</i>	description of formations encountered	from	to
<i>Sylvestown, Miss</i> (mailing address)	<i>top soil</i>	<i>0</i>	<i>2</i>
	<i>clay gravel</i>	<i>2</i>	<i>10</i>
	<i>fine sand</i>	<i>10</i>	<i>40</i>
	<i>coarse sand</i>	<i>40</i>	<i>64</i>
WELL LOCATION: sec. <i>29</i> T. <i>2</i> N. R. <i>11</i> E. S. <i>5</i> W. <i>2</i> miles <i>E</i> of <i>Sylvestown</i> (distance) (direction) (nearest town)			
WELL PURPOSE: <i>Home</i> (home, irrigation, municipal, industrial)			
WELL COMPLETION DATA:			
(1) diameter (inches) <i>4"</i>			
(2) total depth (feet) <i>64</i>			
(3) static water level (feet) <i>12</i> below above top of ground.			
(4) casing <i>plastic</i> <i>54</i> (material) (depth) <i>4"</i> (size) If telescope see back.			
(5) screen <i>10 1/2</i> <i>54</i> (length) (depth to top) <i>4"</i> <i>plastic</i> (size) (material)			
(6) pump <i>1/2</i> <i>12</i> (HP) (yield gpm) <i>elect</i> (type power)			
(7) electric log (yes or no) (organization running log)			
(8) how well bottom plugged <i>BWD</i>			
DRILLERS REMARKS: <i>[Signature]</i>			

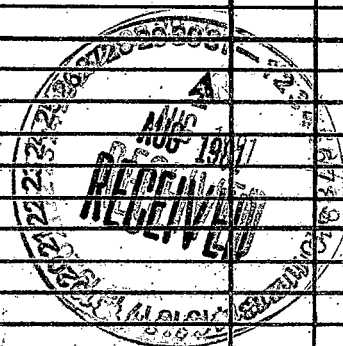

If well telescopes please sketch and show depths.

GROUND LEVEL

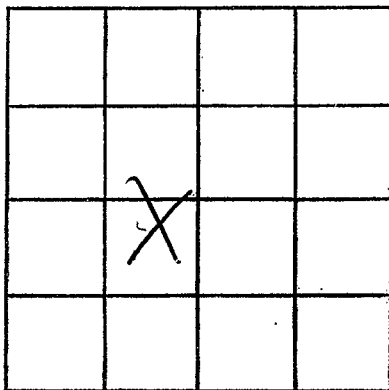

SECTION _____

Please indicate well location X.

ADDITIONAL INFORMATION

If more than one screen, show locations of each on sketch.