

MISSISSIPPI DEPARTMENT OF NATURAL RESOURCES

Bureau of Land and Water Resources

Southport Mall

P.O. Box 10631

Jackson, Mississippi 39209

WATER WELL DRILLERS LOG

TOM GRIFFITH

ZIMMING & WELL SERVICE, INC.

Walthell
F
2039

OK
FIX

date well completed

firm name

county well located

LANDOWNER:

Ben Magee

(mailing address)

WELL LOCATION:

sec. *19* T *2* N R *11* E
 S W
1 miles *N* *Intertown*
 (distance) (direction) (nearest town)

WELL PURPOSE:

(home, irrigation, municipal, industrial)

WELL COMPLETION DATA:

- (1) diameter (inches) *4"*
- (2) total depth (feet) *185'*
- (3) static water level (feet) *45'* below above top of ground.
- (4) casing *P.V.C.* *185'*
 (material) (depth)
- _____ If telescope see back.
 (size)
- (5) screen *20'*
 (length) (depth to top)
4"
 (size) *P.V.C.*
 (material)
- (6) pump *3/4*
 (HP) (yield gpm)
Electric
 (type power)
- (7) electric log *no*
 (yes or no)

(organization running log)

(8) how well bottom plugged *B.W. Valve*

description of formations encountered

from

to

<i>Topsoil</i>	<i>0'</i>	<i>1'</i>
<i>Gravel</i>	<i>1'</i>	<i>65'</i>
<i>Chalk</i>	<i>65'</i>	<i>80'</i>
<i>Peal gravel</i>	<i>80'</i>	<i>115'</i>
<i>Chalk</i>	<i>115'</i>	<i>135'</i>
<i>Sand</i>	<i>135'</i>	<i>185'</i>

DRILLERS REMARKS:


DEPT. OF NATURAL RESOURCES
 BUREAU OF LAND & WATER RESOURCES

AUG - 9 1982

RECEIVED

If well telescopes please sketch and show depths.

GROUND LEVEL

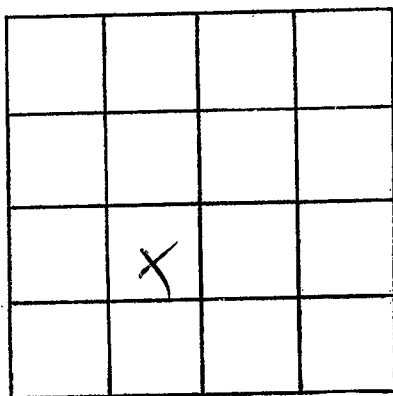

SECTION _____

Please indicate well location X.

ADDITIONAL INFORMATION

If more than one screen,
show locations of each on sketch.