

MISSISSIPPI DEPARTMENT OF NATURAL RESOURCES

Bureau of Land and Water Resources

Southport Mall

P.O. Box 10631

Jackson, Mississippi 39209

WATER WELL DRILLERS LOG

Walchall  
F 2042

11-15 1983  
 date well completed

F. Walchall & Co.  
 firm name

Walchall  
 county well located

LANDOWNER: Kermit Dillion  
P.R. - Lytleton  
 (mailing address)

| description of formations encountered | from      | to         |
|---------------------------------------|-----------|------------|
| <u>Red clay</u>                       | <u>0</u>  | <u>20</u>  |
| <u>Red sand</u>                       | <u>20</u> | <u>90</u>  |
| <u>Coarse sand + gravel</u>           | <u>90</u> | <u>106</u> |

WELL LOCATION:  
 sec. 17 T-2N S R-11E W  
2 miles NE of Lytleton  
 (distance) (direction) (nearest town)

WELL PURPOSE: Drinking  
 (home, irrigation, municipal, industrial)

WELL COMPLETION DATA:

(1) diameter (inches) 4

(2) total depth (feet) 106

(3) static water level (feet) 80 below above top of ground.

(4) casing PVC, 98,  
 (material) (depth)  
4 if telescope see back.  
 (size)

(5) screen 8, 98  
 (length) (depth to top)  
4, PVC  
 (size) (material)

(6) pump 1/2 10  
 (HP) (yield gpm)  
ELC  
 (type power)

(7) electric log no  
 (yes of no)  
Walchall  
 (organization running log)

(8) how well bottom plugged Sealed

DEPT. OF NATURAL RESOURCES  
 BUREAU OF LAND & WATER RESOURCES


DEC - 9 1983

RECEIVED

DRILLERS REMARKS:

If well telescopes please  
sketch and show depths.

GROUND LEVEL

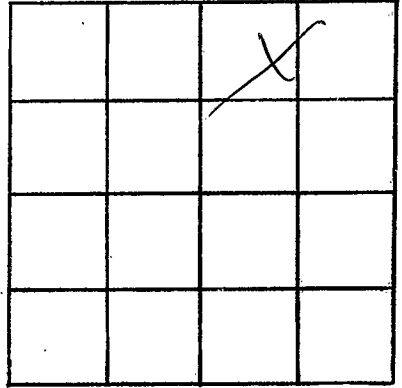

SECTION 17

Please indicate well location X.

ADDITIONAL INFORMATION

If more than one screen,  
show locations of each on sketch.