

Walthall
F 2043

MISSISSIPPI
BOARD OF WATER COMMISSIONERS
416 North State Street
Jackson, Mississippi 39201

WATER WELL DRILLERS LOG

date well completed 19 Stephens Well Ser. firm name Walthall Co county well located

LANDOWNER: Glynn Pittman

Description of formations encountered

from

to

Jayles town, Miss
(mailing address)

Top Soil
Sandy Clay

0 2
2 30

WELL LOCATION:

sec 2 T 2 N R 11 E
S
3 miles North of Jayles town
(distance) (direction) (nearest town)

Clay Gravel
White Chalk

30 90
90 160

WELL PURPOSE: Home
(home, irrigation, municipal, industrial)

Line Sand

160 190

WELL COMPLETION DATA:

- (1) diameter (inches) 4"
- (2) total depth (feet) 226
- (3) static water level (feet) 90 ^{below} _{above} top of ground.
- (4) casing Plastic, 216,
(material) (depth)
4"
(size) if telescope see back.
- (5) screen 10ft., 216
(length) (depth to top)
4", Plastic
(size) (material)
- (6) pump _____ (HP) _____ (yield gpm)
(type power)
- (7) electric log _____ (yes or no)
(organization running log)
- (8) how well bottom plugged BWU

DEPT. OF NATURAL RESOURCES
BUREAU OF LAND & WATER RESOURCES

JAN 23 1984


RECEIVED

DRILLERS REMARKS:

[Handwritten signature]

If well telescopes please sketch and show depths.

GROUND LEVEL

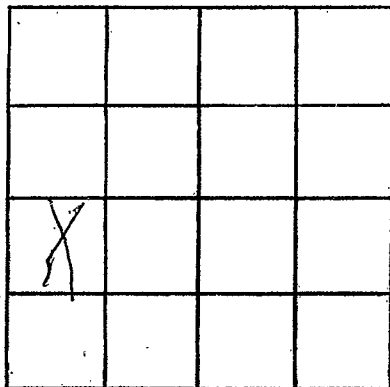

SECTION 2

Please indicate well location X.

ADDITIONAL INFORMATION

If more than one screen, show locations of each on sketch.