

MISSISSIPPI DEPARTMENT OF NATURAL RESOURCES

Bureau of Land and Water Resources

Southport Mall

P.O. Box 10631

Jackson, Mississippi 39209

WATER WELL DRILLERS LOG

Walthell  
BF  
2044

July 24 1984  
 date well completed

Revere Miller  
 firm name

Walthell  
 county well located

LANDOWNER:  
Jimmy Pigott  
Rt 2, Tylitown  
 (mailing address)

description of formations encountered

from to

<u>Clay</u>	<u>0</u>	<u>12</u>
<u>sand</u>	<u>12</u>	<u>75</u>
<u>fluvial sand</u>	<u>75</u>	<u>81</u>

WELL LOCATION:

sec. 5 T. 2 N R. 11 E  
 & W  
3 1/2 miles north of Tylitown  
 (distance) (direction) (nearest town)

WELL PURPOSE: Residential  
 (home, irrigation, municipal, industrial)

WELL COMPLETION DATA:

- (1) diameter (inches) 4"
- (2) total depth (feet) 81
- (3) static water level (feet) 35' below top of ground.
- (4) casing plastic, baton  
 (material) (depth)
- If telescope see back.  
 (size)
- (5) screen 5', 76"  
 (length) (depth to top)
- 4", plastic  
 (size) (material)
- (6) pump 1/2 HP, 10  
 (HP) (yield gpm)
- elect  
 (type power)
- (7) electric log no  
 (yes or no)
- (organization running log)

DEPT. OF NATURAL RESOURCES  
 BUREAU OF LAND & WATER RESOURCES

NOV 21 1984


RECEIVED

(8) how well bottom plugged back well

DRILLERS REMARKS:

If well telescopes please  
sketch and show depths.

GROUND LEVEL

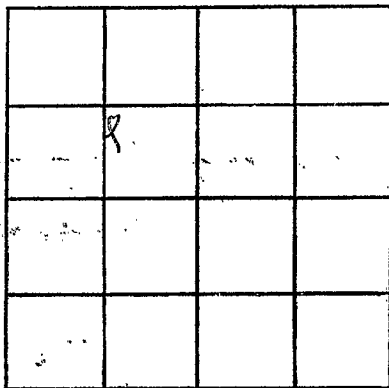

SECTION 5

Please indicate well location X.

ADDITIONAL INFORMATION

If more than one screen,  
show locations of each on sketch.