

Walsh
F
2045

MISSISSIPPI DEPARTMENT OF NATURAL RESOURCES
Bureau of Land and Water Resources
Southport Mall
P.O. Box 10631
Jackson, Mississippi 39209
WATER WELL DRILLERS LOG

4-21 1984 Fitzgerald Well Co Walsh
date well completed firm name county well located

LANDOWNER:	description of formations encountered	from	to
<u>Easley Walker</u> <u>P.O. Taylor, Miss.</u> (mailing address)	<u>Red clay</u> <u>Red sand</u> <u>Coarse sand & gravel</u>	<u>0</u> <u>20</u> <u>105</u>	<u>20</u> <u>105</u> <u>118</u>
WELL LOCATION: sec. <u>1</u> T <u>2</u> N R <u>11</u> E S W <u>8</u> miles <u>E</u> of <u>Floyd</u> (distance) (direction) (nearest town)			
WELL PURPOSE: <u>dr</u> (home, irrigation, municipal, industrial)			
WELL COMPLETION DATA:			
(1) diameter (inches) <u>4</u>			
(2) total depth (feet) <u>118</u>			
(3) static water level (feet) <u>75</u> below above top of ground.			
(4) casing <u>PVC</u> , <u>110</u> , (material) (depth) <u>4</u> if telescope see back. (size)			
(5) screen <u>8</u> , <u>110</u> (length) (depth to top) <u>4</u> , <u>PVC</u> (size) (material)			
(6) pump <u>1/2</u> , <u>10</u> (HP) (yield gpm) <u>dr</u> (type power)			
(7) electric log <u>no</u> (yes or no) <u>Walsh</u> (organization running log)			
(8) how well bottom plugged <u>Sealed</u>			
DRILLERS REMARKS:			


DEPT. OF NATURAL RESOURCES
BUREAU OF LAND & WATER RESOURCES

APR 26 1984

RECEIVED

If well telescopes please
sketch and show depths.

GROUND LEVEL

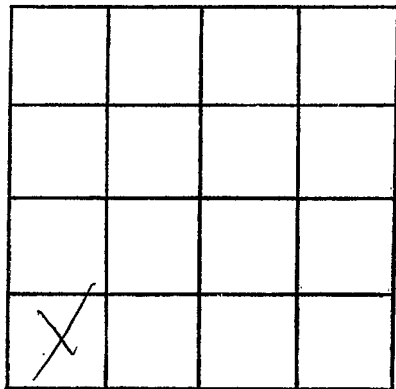

SECTION /

Please indicate well location X.

ADDITIONAL INFORMATION

If more than one screen,
show locations of each on sketch.