

MISSISSIPPI DEPARTMENT OF NATURAL RESOURCES

Bureau of Land and Water Resources

Southport Mall

P.O. Box 10631

Jackson, Mississippi 39209

WATER WELL DRILLERS LOG

Walthall
F 20040

12-10-84
date well completed

84 Fitzgerald Well Drilling Co. Walthall
firm name

county well located

| LANDOWNER: | description of formations encountered | from | to |
|---|---|------------|------------|
| <u>J. Bannor</u> | | | |
| <u>R.R. Lightner</u> (mailing address) | <u>Gravel</u> <u>Chalk</u> <u>white & blue</u> | <u>0</u> | <u>25</u> |
| | <u>SAND</u> | <u>140</u> | <u>168</u> |

WELL LOCATION:
sec 33 T-2 N R-11 E
S W
2 miles E of Lytle
(distance) (direction) (nearest town)

WELL PURPOSE:
(home, irrigation, municipal, industrial)


- WELL COMPLETION DATA:
- (1) diameter (inches) 4
 - (2) total depth (feet) 168
 - (3) static water level (feet) 1 below above top of ground.
 - (4) casing PVC 158,
(material) (depth)
4 if telescope see back.
(size)
 - (5) screen 10, 158
(length) (depth to top)
4, PVC
(size) (material)
 - (6) pump 1/2, 10
(HP) (yield gpm)
EL
(type power)
 - (7) electric log no
(yes or no)
(organization running log)
 - (8) how well bottom plugged Seal blk

Rec'd 1-7-85
JTW

DRILLERS REMARKS:

If well telescopes please
sketch and show depths.

GROUND LEVEL

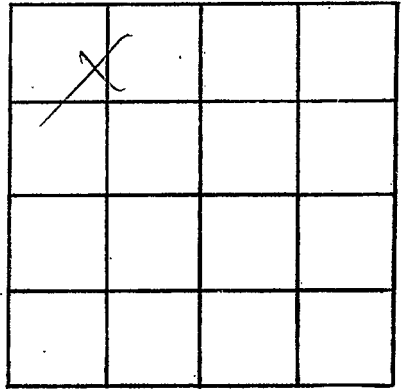

SECTION 33

Please indicate well location X.

ADDITIONAL INFORMATION

If more than one screen,
show locations of each on sketch.