

# MISSISSIPPI DEPARTMENT OF NATURAL RESOURCES

Bureau of Land and Water Resources

P.O. Box 10631

Jackson, Mississippi 39209

## WATER WELL DRILLERS LOG

COUNTY WELL LOCATED <i>Walthall</i>	
WELL NUMBER <i>F</i>	CODED
DATE WELL COMPLETED <i>July 20-89</i>	

PERMIT NUMBER
NAME OF DRILLING FIRM <i>Fitzgould Well Serv</i>

NAME & MAILING ADDRESS OF LANDOWNER <i>Dorothy Loney</i>		
<i>R.B. Tylertown ms.</i>		
WELL LOCATION: SEC	TOWNSHIP	RANGE
<i>20</i>	<i>2</i>	<i>N 11 E</i>
DISTANCE <i>1</i> Miles	DIRECTION <i>NE</i>	NEAREST TOWN <i>Tylertown</i>
OTHER LANDMARK		
WELL PURPOSE: Home, Irrigation, Municipal, Industrial, Fish Pond, etc. <i>Home</i>		

PUMP DATA			
PUMP TYPE (Circle One): <input checked="" type="checkbox"/> Submersible, Turbine, Jet, Flowing Well, Other (Describe) _____			
POWER TYPE (Circle One): <input checked="" type="checkbox"/> Electric, Tractor, Diesel, Gasoline, Butane, Other (Describe) _____ H/P _____			
Pump Capacity (GPM) <i>10</i>	No. of Stages <i>9</i>	Setting Depth <i>80</i> FT.	
PUMP TEST			
Well yielded <i>20</i> GPM with a drawdown of <i>2</i> ft. after <i>2</i> hours of pumping			

WELL DATA		
Well Depth <i>200</i>	Casing Diameter (In.) <i>4</i>	Casing Length (Ft.) <i>10</i>
Type of Casing <i>PVC</i>	Hole Depth <i>200</i>	Depth to Static Water Level <i>50</i>
TYPE OF COMPLETION: (Circle One or More): <input checked="" type="checkbox"/> Gravel Packed, Underreamed, Telescoped, Natural Development, Open Hole, Other (Describe) _____		
Top of Lap Pipe or Reduction in Casing FEET IF TELESKOPED OR MORE THAN ONE SCREEN: USE BACK PAGE		

LOG DATA	
TYPE OF LOG RUN (Circle One): Electric, Gamma Ray, Density, Sonic, Neutron, Other (Describe) _____ <input checked="" type="checkbox"/> No Log Run	
Name of Organization Running Log	

SCREEN DATA		
Diameter - Inches <i>4</i>	Length - Feet <i>10</i>	Slot Size - Inches <i>10/4</i>
Screen Type <i>PVC</i>		Depth to Bottom - Feet <i>200</i>


GEOLOGIC DATA (Office Use Only)			
Surface Elev.	Geologic Unit	Unit Thickness	Depth to Top
Subs. SWL	Date	Analysis	Aquifer Test
Driller's Remarks SEP 12 1989			

DESCRIPTION OF FORMATIONS ENCOUNTERED	FROM	TO	FORMATIONS (continued)	FROM	TO
<i>Red clay</i>	<i>0</i>	<i>10</i>	<i>Dept of Land &amp; Water Resources</i>		
<i>Red sand</i>	<i>20</i>	<i>42</i>	<i>Dept of Land &amp; Water Resources</i>		
<i>white &amp; blue clay</i>	<i>42</i>	<i>182</i>			
<i>Coarse sand &amp; gravel</i>	<i>182</i>	<i>200</i>			

IF MORE SPACE IS NEEDED, USE BACK

If well telescopes please sketch and show depths.

GROUND LEVEL

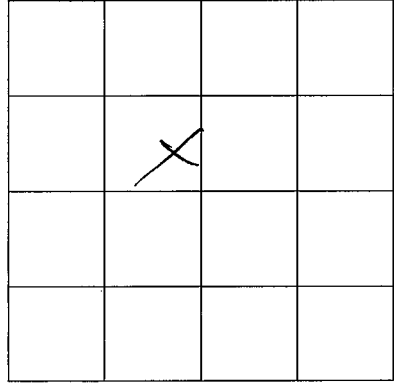

SECTION 20

Please indicate well location X.

ADDITIONAL INFORMATION

If more than one screen,  
show location of each on sketch.