

WALTHALL

F 2080

MISSISSIPPI DEPARTMENT OF NATURAL RESOURCES

Bureau of Land and Water Resources

Southport Mall

P.O. Box 10631

Jackson, Mississippi 39209

WATER WELL DRILLERS LOG

Sept 5

19 90

F. Russell Wiers Law

Walthall

date well completed

firm name

county well located

LANDOWNER:

Paul Fortenberry

R.R. Glectown, Ms.
(mailing address)

description of formations encountered

from

to


Red clay	0	15
Red sand & gravel	15	85
White chalk	85	137
Coarse sand & gravel	137	150

WELL LOCATION:

sec. 34 T 2 N R 11 E
S W
4 miles ESE of Glectown
(distance) (direction) (nearest town)

WELL PURPOSE:

Home
(home, irrigation, municipal, industrial)

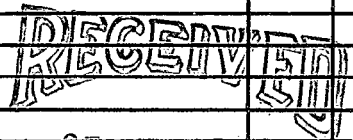


WELL COMPLETION DATA:

- (1) diameter (inches) 4
- (2) total depth (feet) 150
- (3) static water level (feet) 65 below above top of ground.
- (4) casing PVC (material), (depth),
4 (size) if telescope see back.
- (5) screen 10 (length), 140 (depth to top)
4 (size), 10 (material)
- (6) pump 1/2 (HP), 10 (yield gpm)
Electric (type power)
- (7) electric log No (yes or no)
(organization running log)
- (8) how well bottom plugged Sand blk

DRILLERS REMARKS:

If well telescopes please sketch and show depths.

GROUND LEVEL

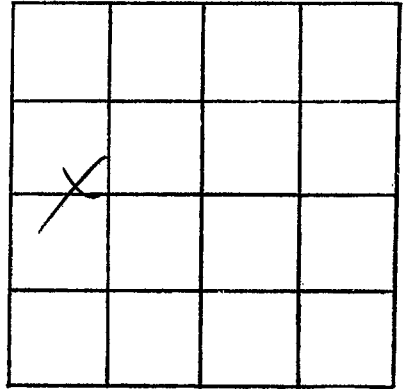

SECTION 34

Please indicate well location X.

ADDITIONAL INFORMATION

If more than one screen,
show locations of each on sketch.