

MISSISSIPPI DEPARTMENT OF ENVIRONMENTAL QUALITY

Office of Land and Water Resources

P. O. Box 10631
Jackson, MS 39289-0631
WATER WELL DRILLERS LOG

COUNTY WELL LOCATED
Walsh

WELL NUMBER F CODED

DATE WELL COMPLETED
2057
MAY 31-94

PERMIT NUMBER

NAME OF DRILLING FIRM
FITZGERALD Well Serv

NAME & MAILING ADDRESS OF LANDOWNER
Mike Coleman
RR. Tylertown

WELL LOCATION: SEC 7 TOWNSHIP 2 RANGE 11
N S E W

DISTANCE 2 Miles DIRECTION H of Tylertown

OTHER LANDMARK

WELL PURPOSE: Home, Irrigation, Municipal, Industrial, Fish Pond, etc.
Home

PUMP DATA

PUMP TYPE (Circle One):
Submersible, Turbine, Jet, Flowing Well,
Other (Describe)

POWER TYPE (Circle One):
Electric, Tractor, Diesel, Gasoline, Butane,
Other (Describe) H/P 3/4

Pump Capacity (GPM) <u>10</u>	No. of Stages <u>12</u>	Setting Depth <u>90</u> FT.
----------------------------------	----------------------------	--------------------------------

PUMP TEST

Well yielded 25 GPM with
a drawdown of 2 ft.
after 2 hours of pumping

WELL DATA

Well Depth <u>159</u>	Casing Diameter (In.) <u>4</u>	Casing Length (Ft.) <u>149</u>
Type of Casing <u>NWC</u>	Hole Depth <u>159</u>	Depth to Static Water Level <u>46</u>

LOG DATA

TYPE OF LOG RUN (Circle One):
No Log Run,
Electric, Gamma Ray, Density, Sonic, Neutron,
Other (Describe)

Name of Organization Running Log

TYPE OF COMPLETION: (Circle One or More):
Gravel Packed, Underreamed, Telescoped,
Natural Development, Open Hole, Other
(Describe)

GEOLOGIC DATA (Office Use Only)

Surface Elev.	Geologic Unit	Unit Thickness	Depth to Top
Subs. SWL	Date	Analysis	Aquifer Test

WELL GROUTED TO A DEPTH OF 10 FEET
Type Grout (circle one): Cement, Bentonite, or Mix

SCREEN DATA

Diameter - Inches <u>4</u>	Length - Feet <u>10</u>	Slot Size - Inches <u>10/10</u>
Screen Type <u>NWC</u>	Depth to Bottom - Feet <u>159</u>	

Driller's Remarks

RECEIVED

Top of Lap Pipe or Reduction in Casing

JUNE 7 1994

IF UNDESIGNED OR MORE THAN ONE SCREEN: USE BACK PAGE


DESCRIPTION OF FORMATIONS ENCOUNTERED	FROM TO		FORMATIONS (Continued)	FROM TO	
<u>Red Clay</u>	<u>0</u>	<u>20</u>			
<u>Red Silty</u>	<u>20</u>	<u>60</u>			
<u>Blue Clay</u>	<u>60</u>	<u>141</u>			
<u>Coarse Sand</u>	<u>141</u>	<u>159</u>			

Dept. of Environmental Quality
Office of Land & Water Resources

IF MORE SPACE IS NEEDED, USE BACK

If well telescopes please
sketch and show depths.

GROUND LEVEL

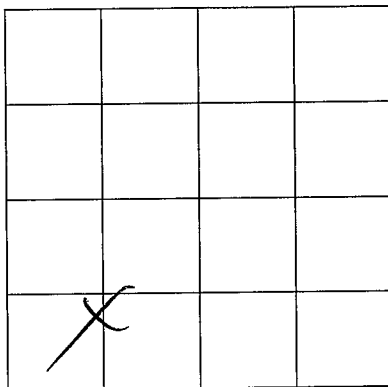

SECTION 7

Please indicate well location X.

ADDITIONAL INFORMATION

If more than one screen,
show location of each on sketch.