

MISSISSIPPI DEPARTMENT OF ENVIRONMENTAL QUALITY

Office of Land and Water Resources

P. O. Box 10631
Jackson, MS 39289-0631

WATER WELL DRILLERS LOG

COUNTY WELL LOCATED <i>Walthall</i>	
WELL NUMBER <i>F</i>	CODED
DATE WELL COMPLETED <i>2058</i>	
<i>Dec 15-94</i>	

PERMIT NUMBER
NAME OF DRILLING FIRM <i>E. T. GERMA Well Service</i>

NAME & MAILING ADDRESS OF LANDOWNER <i>Edward Magee</i>			
<i>Lottie Magee Rel, Lytleton</i>			
WELL LOCATION	SEC	TOWNSHIP	RANGE
	<i>12</i>	<i>2</i>	<i>N 11 W</i>
DISTANCE	DIRECTION	NEAREST TOWN	
<i>7</i> Miles	<i>E</i>	of <i>Lytleton</i>	
OTHER LANDMARK			
WELL PURPOSE: Home, Irrigation, Municipal, Industrial, Fish Pond, etc. <i>Home</i>			

PUMP DATA		
PUMP TYPE (Circle One): <input checked="" type="radio"/> Submersible, <input type="radio"/> Turbine, <input type="radio"/> Jet <input type="radio"/> Flowing Well, Other (Describe) _____		
POWER TYPE (Circle One): <input checked="" type="radio"/> Electric, <input type="radio"/> Tractor, <input type="radio"/> Diesel, <input type="radio"/> Gasoline, <input type="radio"/> Butane, Other (Describe) _____ H/P <i>1/2</i>		
Pump Capacity (GPM)	No. of Stages	Setting Depth
<i>10</i>	<i>9</i>	<i>135</i> FT.
PUMP TEST		
Well yielded <i>25</i> GPM with a drawdown of <i>2</i> ft. after <i>2</i> hours of pumping		

WELL DATA		
Well Depth <i>160</i>	Casing Diameter (In.) <i>4</i>	Casing Length (Ft.) <i>150</i>
Type of Casing <i>MK</i>	Hole Depth <i>160</i>	Depth to Static Water Level <i>92</i>

LOG DATA	
TYPE OF LOG RUN (Circle One): <input type="radio"/> Electric, <input type="radio"/> Gamma Ray, <input type="radio"/> Density, <input type="radio"/> Sonic, <input checked="" type="radio"/> Neutron, Other (Describe) _____	
Name of Organization Running Log	

TYPE OF COMPLETION: (Circle One or More): <input checked="" type="checkbox"/> Gravel Packed, <input type="checkbox"/> Underreamed, <input type="checkbox"/> Telescoped, <input type="checkbox"/> Natural Development, <input type="checkbox"/> Open Hole, <input type="checkbox"/> Other			
(Describe) _____			
WELL GROUTED TO A DEPTH OF <i>60</i> FEET			
Type Grout (circle one): Cement, Bentonite, or <input checked="" type="radio"/> Mix			

GEOLOGIC DATA (Office Use Only)			
Surface Elev.	Geologic Unit	Unit Thickness	Depth to Top
Subs. SWL	Date	Analysis	Aquifer Test

SCREEN DATA		
Diameter - Inches <i>4</i>	Length - Feet <i>10</i>	Slot Size - Inches <i>10/12</i>
Screen Type <i>JK</i>	Depth to Bottom - Feet <i>160</i>	

Driller's Remarks	
Top of Lap Pipe or Reduction in Casing	
FEET	IF TELESCOPED OR MORE THAN ONE SCREEN: USE BACK PAGE

DESCRIPTION OF FORMATIONS ENCOUNTERED	FROM	TO	FORMATIONS ENCOUNTERED	FROM	TO
<i>Red Clay</i>	<i>0</i>	<i>20</i>			
<i>Red Sand</i>	<i>20</i>	<i>117</i>			
<i>Coarse Sand & gravel</i>	<i>117</i>	<i>160</i>			

RECEIVED


DEC 29 1994

Dept. of Environmental Quality
Office of Land & Water Resources

IF MORE SPACE IS NEEDED, USE BACK

If well telescopes please sketch and show depths.

GROUND LEVEL

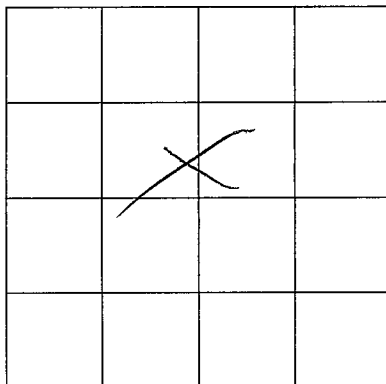

SECTION _____

Please indicate well location X.

ADDITIONAL INFORMATION

If more than one screen,
show location of each on sketch.