

MISSISSIPPI DEPARTMENT OF ENVIRONMENTAL QUALITY

Office of Land and Water Resources

P. O. Box 10631
Jackson, MS 39289-0631

WATER WELL DRILLERS LOG

COUNTY WELL LOCATED <u>WALTON</u>	
WELL NUMBER <u>F</u>	CODED
DATE WELL COMPLETED <u>2009</u> <u>MAY 20/95</u>	

PERMIT NUMBER
NAME OF DRILLING FIRM <u>Fitzgerald Well Serv.</u>

NAME & MAILING ADDRESS OF LANDOWNER <u>SRV:4 GINN</u> <u>RR. Lytleston ms.</u>			
WELL LOCATION:	SEC	TOWNSHIP	RANGE
	<u>20</u>	<u>2</u>	<u>N 11 E</u>
DISTANCE	DIRECTION	NEAREST TOWN	
<u>1</u> Miles	<u>E</u>	<u>Lytleston</u>	
OTHER LANDMARK			
WELL PURPOSE: <input checked="" type="checkbox"/> Home Irrigation, <input type="checkbox"/> Municipal, <input type="checkbox"/> Industrial, <input type="checkbox"/> Fish Pond, etc.			

PUMP DATA			
PUMP TYPE (Circle One): <input checked="" type="checkbox"/> Submersible, <input type="checkbox"/> Turbine, <input type="checkbox"/> Jet, <input type="checkbox"/> Flowing Well, Other (Describe) _____			
POWER TYPE (Circle One): <input checked="" type="checkbox"/> Electric, <input type="checkbox"/> Tractor, <input type="checkbox"/> Diesel, <input type="checkbox"/> Gasoline, <input type="checkbox"/> Butane, Other (Describe) _____ H/P <u>3/4</u>			
Pump Capacity (GPM) <u>15</u>	No. of Stages <u>12</u>	Setting Depth <u>90</u>	FT.
PUMP TEST			
Well yielded <u>25</u> GPM with a drawdown of <u>20</u> ft. after <u>1</u> hours of pumping			

WELL DATA		
Well Depth <u>100</u>	Casing Diameter (In.) <u>4</u>	Casing Length (Ft.) <u>90</u>
Type of Casing <u>PVC</u>	Hole Depth <u>100</u>	Depth to Static Water Level <u>30</u>

LOG DATA	
TYPE OF LOG RUN (Circle One): Electric, Gamma Ray, Density, Sonic, <input checked="" type="checkbox"/> <u>No Log Run</u> , Other (Describe) <u>Neutron</u>	
Name of Organization Running Log	

TYPE OF COMPLETION: (Circle One or More): <input checked="" type="checkbox"/> Gravel Packed, <input type="checkbox"/> Underreamed, <input type="checkbox"/> Telescoped, <input type="checkbox"/> Natural Development, <input type="checkbox"/> Open Hole, <input type="checkbox"/> Other			
WELL GROUTED TO A DEPTH OF <u>10</u> FEET Type Grout (circle one): Cement, Bentonite, <input checked="" type="checkbox"/> <u>or Mix</u>			

GEOLOGIC DATA (Office Use Only)			
Surface Elev.	Geologic Unit	Unit Thickness	Depth to Top
Subs. SWL	Date	Analysis	Aquifer Test

SCREEN DATA			
Diameter - Inches <u>4</u>	Length - Feet <u>10</u>	Slot Size - Inches <u>10/32</u>	
Screen Type <u>PVC</u>	Depth to Bottom - Feet. <u>100</u>		

Driller's Remarks			

DESCRIPTION OF FORMATIONS ENCOUNTERED	FROM	TO	FORMATIONS CONTAINED BETWEEN FROM	TO
<u>Red Clay</u>	<u>0</u>	<u>10</u>		
<u>Red Sand</u>	<u>10</u>	<u>30</u>		
<u>white chalk</u>	<u>30</u>	<u>84</u>		
<u>COURSE SAND + GRAVEL</u>	<u>84</u>	<u>100</u>		

RECEIVED


JUN 26 1995

Dept. of Environmental Quality
Office of Land & Water Resources

IF MORE SPACE IS NEEDED, USE BACK

If well telescopes please sketch and show depths.

GROUND LEVEL

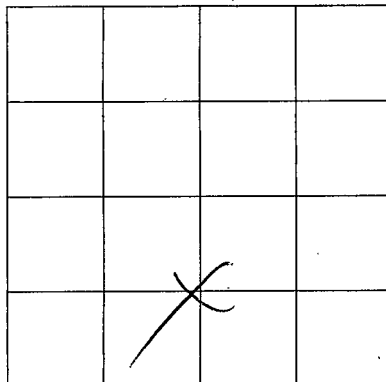

SECTION 20

Please indicate well location X.

ADDITIONAL INFORMATION

If more than one screen,
show location of each on sketch.