

WALTHALL
G
2-73

MISSISSIPPI
 BOARD OF WATER COMMISSIONERS
 416 North State Street
 Jackson, Mississippi 39201

CODED


WATER WELL DRILLERS LOG

Feb. 1973 E.B. Sheppard Walthall
 date well completed firm name county well located

LANDOWNER:	description of formations encountered	from	to
Arnell Magee Jylertown, Miss (mailing address)	BED CLAY GRAVEL GRAVEL-LOOSE SANDY CLAY COARSE PEA GR.	0 90 115 140 160	90 115 140 160
WELL LOCATION: sec <u>20</u> T <u>2</u> N R <u>12</u> E 8 miles E Jylertown (distance) (direction) (nearest town)			
WELL PURPOSE: (home) irrigation, municipal, industrial			
WELL COMPLETION DATA: (1) diameter (inches) <u>2"</u> (2) total depth (feet) <u>160</u> (3) static water level (feet) <u>130</u> ^{below} <u>above</u> top of ground. (4) casing <u>pl.</u> <u>155'</u> (material) (depth) <u>2"</u> (size) if telescope see back. (5) screen <u>5'</u> (length) (depth to top) <u>2"</u> <u>pl.</u> (size) (material) (6) pump <u>1 1/2</u> <u>7</u> (HP) (yield gpm) <u>8</u> (type power) (7) electric log <u>(yes or no)</u> (organization running log) (8) how well bottom plugged <u>BWV</u>	<div data-bbox="642 1046 878 1173" style="text-align: center; border: 1px solid black; padding: 5px; transform: rotate(-5deg);"> CODED </div>		
DRILLERS REMARKS:			

If well telescopes please sketch and show depths.

GROUND LEVEL

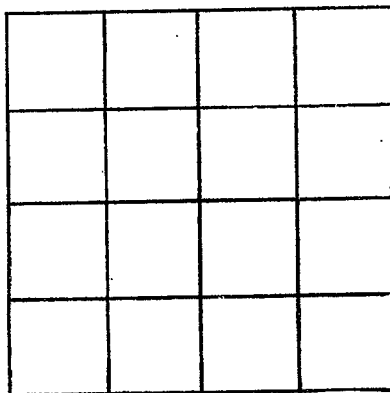

SECTION _____

Please indicate well location X.

ADDITIONAL INFORMATION

If more than one screen, show locations of each on sketch.