

**MISSISSIPPI
BOARD OF WATER COMMISSIONERS**
416 North State Street
Jackson, Mississippi 39201

CODED

WATER WELL DRILLERS LOG

WalThall
G-2
6-16-71

June 16 1971 chester keener walthall
date well completed firm name county well located

LANDOWNER: L.W. Magee
RFD 2,
Tylertown -
(mailing address)

WELL LOCATION:
sec 27 T 2 N R. 12 E
10 miles E of Tylertown
(distance) (direction) (nearest town)

WELL PURPOSE:
(home, irrigation, municipal, industrial)
Home

- WELL COMPLETION DATA:
- (1) diameter (inches) 4"
 - (2) total depth (feet) 208
 - (3) static water level (feet) 111 below above top of ground.
 - (4) casing Plat Sattam
(material) (depth)
6" if telescope see back. (size)
 - (5) screen 6' 207
(length) (depth to top)
4" (size) Plat (material)
 - (6) pump 1/2 Sub 12
(HP) (yield gpm)
elect (type power)
 - (7) electric log NO
(yes or no)
 - (organization running log)
 - (8) how well bottom plugged wooden plug

description of formations encountered	from	to
Clay & small gravel	0	35
Red Sand	35	90
Sand & gravel	90	108
yellow CODED	108	195
Coarse sand & fine gravel	195	208

CODED


SEP 20 1971

DRILLERS REMARKS:
new house

MISSISSIPPI BD. OF
WATER COMMISSIONERS

If well telescopes please sketch and show depths.

GROUND LEVEL

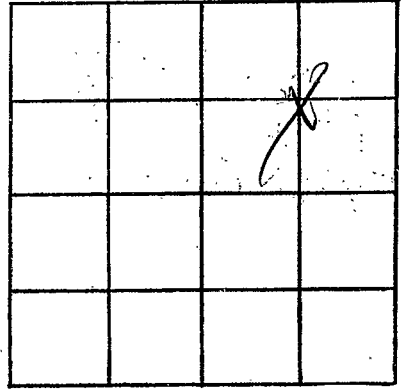

SECTION 27

Please indicate well location X.

ADDITIONAL INFORMATION

If more than one screen, show locations of each on sketch.