

MISSISSIPPI BOARD OF WATER COMMISSIONERS

WALTHALL

G3

CODED

WATER WELL DRILLERS LOG

6-29-66

Date: 6/29, 1966, Driller: T. B. Andrews County Walthall

(Name)

(1) Owner of Land: Whit Blackwell
 (Name)
Rt. 4 Tylertown Miss
 (Address)

(2) Location: 1/4, 1/4, Sec. 33 T2R12
3 miles N, of Mesa
 (distance) (direction) (Nearest Town)

(3) Topography: Hilly
 (Hilly) (Flat) (Level)

(4) Purpose of Well: Domestic
 (Domestic Irrigation
 Municipal, Industrial, Other)

Description & Color of Materials Sand, Clay, Red Clay, Shell, etc.	Thick- ness Feet	Depth Feet
0' to 40' Red Clay		
40' to 80' Sand & Chalk		
80' to 100' Sand		
100' to 120' Sand & gravel		


Information upon completion of well:

- (1) Diameter 4 inches.
 (2) Total Depth 120 feet.
 (3) Water Level 95 feet below top of ground.
 (4) Cased to 120', Size 4"
 (5) Screen: Size 4", Length 6'
 (6) Were any formations sealed against pollution?
 _____ yes, no.

If YES depth of formation _____
 Why _____

Drillers Remarks:
Plastic well

CODED

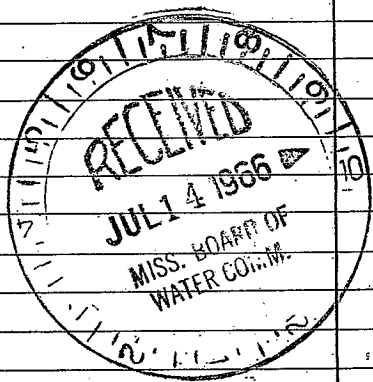

(Use Back Side)

Well No.

100

101

102

200