

WALTHALL  
64  
2-67 CODED

MISSISSIPPI  
BOARD OF WATER COMMISSIONERS  
416 North State Street  
Jackson, Mississippi 39201

WATER WELL DRILLERS LOG

Feb. 1 1967 Feltner & Elbert Blount WALTHALL  
date well completed firm name county well located

LANDOWNER:

James Riley

description of formations encountered

from

to

Tyler-Town Miss.  
(mailing address)

Red CLAY  
SAND  
GRAVEL  
SAND  
GRAVEL

0 20  
20 60  
60 80  
80 105  
105 127

WELL LOCATION:

sec. 21 T. 20 N. R. 12 E. S. W.  
10 miles E of Tyler-Town  
(distance) (direction) (nearest town)

WELL PURPOSE:

Home  
(home, irrigation, municipal, industrial)


WELL COMPLETION DATA:

- (1) diameter (inches) 4"
- (2) total depth (feet) 127
- (3) static water level (feet) 96 below above top of ground.
- (4) casing PLASTIC 127'  
(material) (depth)  
4" if telescope see back.  
(size)
- (5) screen 6' 121'  
(length) (depth to top)  
4" PLASTIC  
(size) (material)
- (6) pump 1 5 GAL  
(HP) (yield gpm)  
Elect  
(type power)
- (7) electric log (yes or no)

(organization running log)

(8) how well bottom plugged

DRILLERS REMARKS:

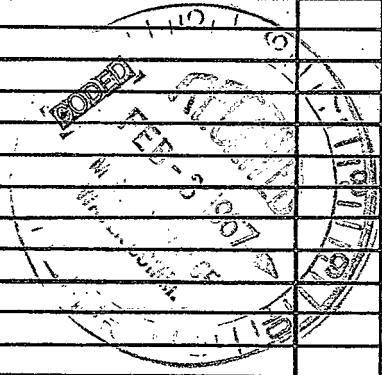

If well telescopes please sketch and show depths.

GROUND LEVEL

	X		

SECTION 21

Please indicate well location X.

ADDITIONAL INFORMATION

If more than one screen, show locations of each on sketch.