

WALTHALL  
G5  
1-67

MISSISSIPPI  
BOARD OF WATER COMMISSIONERS  
416 North State Street  
Jackson, Mississippi 39201

CODED

WATER WELL DRILLERS LOG

JAN 19 1967 Fernie Elbert Brown WALTHALL  
date well completed firm name county well located

LANDOWNER: MURPHY Lowery  
Foxworth RT. 2  
MISS.  
(mailing address)


WELL LOCATION:  
sec. 35 T. 2 (N) R. 12 (E)  
S W  
15 miles E of TYLETOWN  
(distance) (direction) (nearest town)

WELL PURPOSE: Home  
(home, irrigation, municipal, industrial)

- WELL COMPLETION DATA:
- (1) diameter (inches) 2"
  - (2) total depth (feet) 163'
  - (3) static water level (feet) 135' below above top of ground.
  - (4) casing GAU. 163'  
(material) (depth)  
2"  
(size) if telescope see back.
  - (5) screen 5' 158'  
(length) (depth to top)  
2" STAINLESS STEEL  
(size) (material)
  - (6) pump 3A 4 GAL.  
(HP) (yield gpm)  
ELECT.  
(type power)
  - (7) electric log (yes or no) \_\_\_\_\_  
(organization running log) \_\_\_\_\_
  - (8) how well bottom plugged \_\_\_\_\_

description of formations encountered	from	to
RED CLAY	0	20
FINE SAND	20	80
GRAVEL	80	85
SAND	85	95
GRAVEL	95	163
WHITE CLAY	163	164


CODED

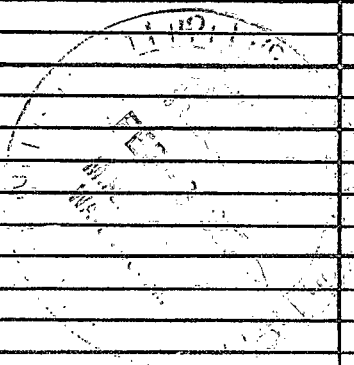

DRILLERS REMARKS: ROD  
TYPE PUMP

If well telescopes please sketch and show depths.

GROUND LEVEL

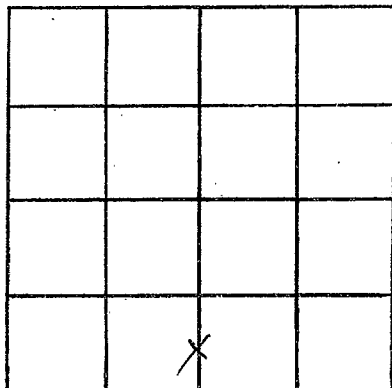

SECTION 36

Please indicate well location X.

ADDITIONAL INFORMATION

If more than one screen, show locations of each on sketch.