

WALTHALL
 67
 6-2-67

MISSISSIPPI
 BOARD OF WATER COMMISSIONERS
 416 North State Street
 Jackson, Mississippi 39201

CODED

WATER WELL DRILLERS LOG

6/2 1967 Andrus Drilling Co. Walthall
 date well completed firm name county well located

LANDOWNER: Joseph Stogden
P.O. 2 Tylertown, Miss
39667
 (mailing address)

WELL LOCATION:
 sec. 18 T. 2 N. R. 12 E.
5 miles S.W. of Dextre
 (distance) (direction) (nearest town)


WELL PURPOSE: Home
 (home, irrigation, municipal, industrial)

WELL COMPLETION DATA:

- (1) diameter (inches) 4"
- (2) total depth (feet) 130'
- (3) static water level (feet) 83' below top of ground.
- (4) casing P.V.C., 124'
 (material) (depth)
4" if telescope see back.
 (size)
- (5) screen 6', 130'
 (length) (depth to top)
4", P.V.C.
 (size) (material)
- (6) pump 1/2, 10 gal.
 (HP) (yield gpm)
- R.E.A. 220
 (type power)
- (7) electric log No
 (yes or no)
- (organization running log)
- (8) how well bottom plugged Back Wash Valve

description of formations encountered	from	to
<u>Red Clay</u>	<u>0'</u>	<u>30'</u>
<u>Sand</u>	<u>30'</u>	<u>60'</u>
<u>Gravel</u>	<u>60'</u>	<u>70'</u>
<u>Chalk</u>	<u>70'</u>	<u>110'</u>
<u>Sand</u>	<u>110'</u>	<u>130'</u>
<u>Coarse Sand / Gravel</u>	<u>110'</u>	<u>130'</u>


CODED

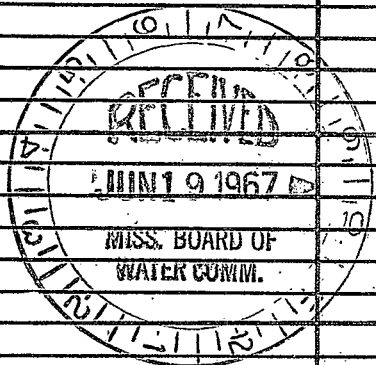

DRILLERS REMARKS:

If well telescopes please sketch and show depths.

GROUND LEVEL

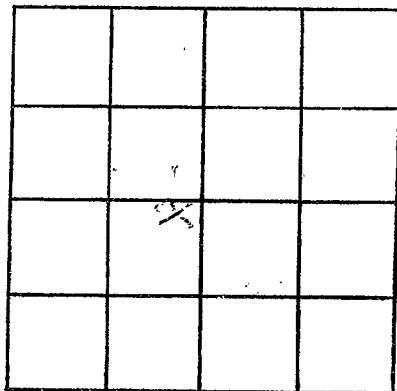

SECTION 18

Please indicate well location X.

ADDITIONAL INFORMATION

If more than one screen,
show locations of each on sketch.