

WALTHALL
G8
1-13-71

MISSISSIPPI
BOARD OF WATER COMMISSIONERS
416 North State Street
Jackson, Mississippi 39201

CODED

WATER WELL DRILLERS LOG

1-13 1971 *Earley Staffed Well Service* *Walthall*
date well completed firm name county well located

LANDOWNER: *Julianus Piggot*
Route 2, Box 171
Tylertown, Miss.
(mailing address)

description of formations encountered	from	to
	<i>Red Clay</i>	<i>0</i>
<i>Sand + Gravel</i>	<i>18</i>	<i>50</i>

WELL LOCATION:
sec. 33 T 2 N R 12 E
B W
_____ miles _____ of _____
(distance) (direction) (nearest town)

WELL PURPOSE:
(home, irrigation, municipal, industrial)

- WELL COMPLETION DATA:
- (1) diameter (inches) 4
 - (2) total depth (feet) 50ft
 - (3) static water level (feet) _____ below above top of ground.
 - (4) casing Plastic, 40 ft,
(material) (depth)
4 if telescope see back.
(size)
 - (5) screen 10ft, 40ft
(length) (depth to top)
4 in., Plastic
(size) (material)
 - (6) pump _____ (HP) _____ (yield gpm)

(type power)
 - (7) electric log _____ (yes or no)

(organization running log)
 - (8) how well bottom plugged B.W.V.

CODED


JAN 28 1971

MISS. BD. OF
WATER COMM.

DRILLERS REMARKS:
Charles Stafford

If well telescopes please sketch and show depths.

GROUND LEVEL

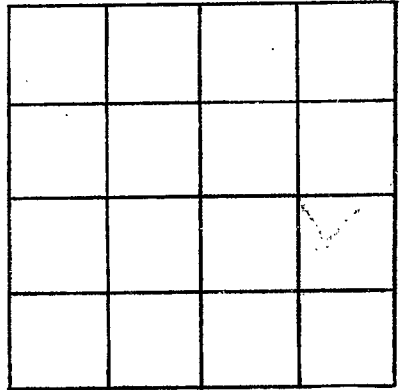

SECTION _____

Please indicate well location X.

ADDITIONAL INFORMATION

If more than one screen, show locations of each on sketch.