

WALTHALL  
G9  
11-70

MISSISSIPPI  
BOARD OF WATER COMMISSIONERS  
416 North State Street  
Jackson, Mississippi 39201

**CODED**

WATER WELL DRILLERS LOG

Nov 1970 E.B. SHERRARD WALTHALL  
date well completed firm name county well located

LANDOWNER:

R.D. Bullock  
P.O. 2-Tylertown, Miss.  
(mailing address)

description of formations encountered from to

<u>GRAY SANDY CLAY</u>		
<u>RED SANDY CLAY</u>	<u>0</u>	<u>70'</u>
<u>EAUSTELIC DR</u>	<u>70</u>	<u>80'</u>
<u>CR AVEL</u>	<u>80</u>	<u>110'</u>
<u>COARSE SAND</u>		
<u>LAYERED PEA-C.</u>	<u>110</u>	<u>138'</u>

WELL LOCATION:

sec 21 T 2 N R 12 E  
9 miles E of TYLERTOWN  
(distance) (direction) (nearest town)

WELL PURPOSE:  
(home) Irrigation, municipal, industrial

WELL COMPLETION DATA:

- (1) diameter (inches) 2"
- (2) total depth (feet) 138
- (3) static water level (feet) 110 <sup>below</sup>/<sub>above</sub> top of ground.
- (4) casing PL (material), 133 (depth)  
2" (size) if telescope see back.
- (5) screen 5' (length), (depth to top)  
2" (size), SS. (material)
- (6) pump 1 1/2 HP. (HP), 7 (yield gpm)  
E (type power)
- (7) electric log (yes or no)

(organization running log)

(8) how well bottom plugged BWV

DRILLERS REMARKS:


**CODED**

FEB 7 1971

MISS. BD. OF WATER COM.

If well telescopes please sketch and show depths.

GROUND LEVEL

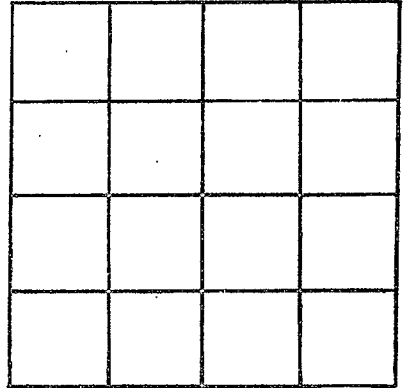

SECTION \_\_\_\_\_

Please indicate well location X.

ADDITIONAL INFORMATION

If more than one screen, show locations of each on sketch.