

MISSISSIPPI  
BOARD OF WATER COMMISSIONERS  
416 North State Street  
Jackson, Mississippi 39201

WATER WELL DRILLERS LOG

**CODED**

Walthal  
G-11  
7-12-71

July 12 1971 date well completed  
Chester Keene Walthal firm name  
county well located

LANDOWNER: Dr. Johnson  
Rt 2  
Tylertown  
(mailing address)

description of formations encountered	from	to
Red Sandy clay	0	25
Red Sand	25	100
Gravel Sand	100	108
Red Sand & Chalk	108	155
Coarse Sand	155	167

WELL LOCATION:  
sec. 27 T 2 N R. 12 E  
10 miles E of Tylertown  
(distance) (direction) (nearest town)

WELL PURPOSE: Home  
(home, irrigation, municipal, industrial)

- WELL COMPLETION DATA:
- (1) diameter (inches) 4 1/2
  - (2) total depth (feet) 167
  - (3) static water level (feet) 107 below top of ground.
  - (4) casing Plast Balltown  
(material) (depth)
  - (size) if telescope see back.
  - (5) screen 6' 167'  
(length) (depth to top)
  - (size) 4" Plast  
(size) (material)
  - (6) pump 1/2 HP 10  
(HP) (yield gpm)
  - (type power) Elect
  - (7) electric log no  
(yes or no)
  - (organization running log)
  - (8) how well bottom plugged wood plug

**CODED**


SEP 20 1971

DRILLERS REMARKS:  
new hand

MISC. DIV. OF  
WATER ENGINEERING

If well telescopes please sketch and show depths.

GROUND LEVEL

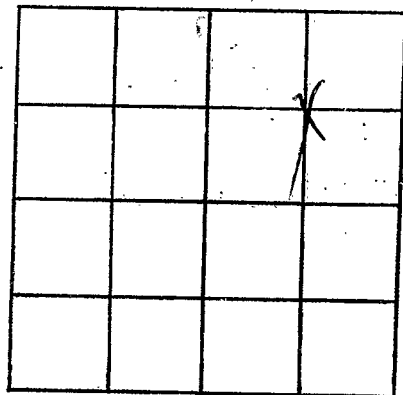

SECTION 27

Please indicate well location X.

ADDITIONAL INFORMATION

If more than one screen, show locations of each on sketch.