

WALTHALL

G12

4-25-72

MISSISSIPPI BOARD OF WATER COMMISSIONERS
416 North State Street
Jackson, Mississippi 39201

CODED

WATER WELL DRILLERS LOG

April 25 1972 R. Woodward Drilling Walthall
date well completed firm name county well located

LANDOWNER: <u>J. L. Bullock</u>	description of formations encountered	from	to
<u>Pt. 2 B of 164</u>			
<u>Tylertown, Miss.</u> (mailing address)	<u>hard gravel</u>	<u>25</u>	<u>70</u>
WELL LOCATION: sec. <u>32</u> T. <u>2</u> N. R. <u>12</u> E <u>2</u> miles <u>NW</u> of <u>Defer</u> (distance) (direction) (nearest town)	<u>Purple clay</u>	<u>70</u>	<u>74</u>
WELL PURPOSE: <u>Home</u> (home, irrigation, municipal, industrial)	<u>Gravel</u>	<u>74</u>	<u>94</u>
WELL COMPLETION DATA: (1) diameter (inches) <u>4"</u> (2) total depth (feet) <u>94'</u> (3) static water level (feet) <u>75</u> below above top of ground. (4) casing <u>PVC</u> , <u>84'</u> (material) (depth) <u>4"</u> if telescope see back. (size) (5) screen <u>10'</u> , <u>84'</u> (length) (depth to top) <u>4"</u> , <u>PVC pipe</u> (size) (material) (6) pump <u>1/2</u> , <u>8</u> (HP) (yield gpm) <u>115 V AC</u> (type power) (7) electric log _____ (yes or no) (organization running log) (8) how well bottom plugged <u>float</u> <u>logs B & V</u>			
DRILLERS REMARKS:			


CODED

MAY 1 - 1972

MISS. Bd. OF WATER COMMISSIONERS

If well telescopes please sketch and show depths.

GROUND LEVEL

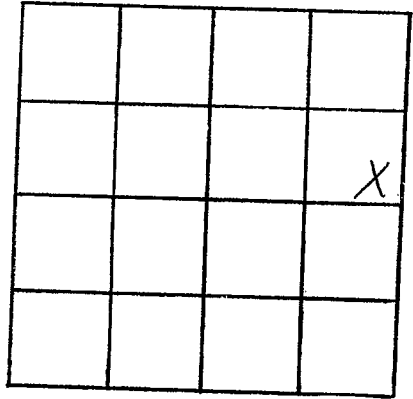

SECTION 32

Please indicate well location X.

ADDITIONAL INFORMATION

If more than one screen,
show locations of each on sketch.