

WALTHALL
G13
6-7-72

MISSISSIPPI
 BOARD OF WATER COMMISSIONERS
 416 North State Street
 Jackson, Mississippi 39201

WATER WELL DRILLERS LOG

CODED

June 7 1972 B. Woodman Drilling Walthall
 date well completed firm name county well located

LANDOWNER: <u>S.L. Easterling</u>	description of formations encountered	from	to
<u>Tylertown, Miss.</u> (mailing address)			
WELL LOCATION: sec. <u>33</u> T. <u>2</u> N. R. <u>12</u> E. <u>1.5</u> miles <u>NORTH</u> of <u>DEXTER</u> (distance) (direction) (nearest town)	<u>Red clay</u>		<u>10'</u>
	<u>Sand and gravel</u>	<u>10</u>	<u>65</u>
	<u>Clay</u>	<u>65</u>	<u>98</u>
	<u>Coarse sand</u>	<u>98</u>	<u>110'</u>
WELL PURPOSE: <u>Home</u> (home, irrigation, municipal, industrial)			
WELL COMPLETION DATA:			
(1) diameter (inches) <u>4"</u>			
(2) total depth (feet) <u>110'</u>			
(3) static water level (feet) <u>35</u> below above top of ground.			
(4) casing <u>PVC</u> , <u>100'</u> (material) (depth) <u>4"</u> if telescope see back. (size)			
(5) screen <u>10'</u> , <u>100'</u> (length) (depth to top) <u>4"</u> , <u>PVC</u> (size) (material)			
(6) pump <u>1</u> <u>6</u> (HP) (yield gpm) <u>115 V AC</u> (type power)			
(7) electric log <u>NO</u> (yes or no)			
(organization running log)			
(8) how well bottom plugged <u>Flat</u> <u>Type 0.5V</u>			

CODED


RECORDED
 JUN 12 1972

MISS. BD. OF
 WATER COM.

DRILLERS REMARKS:

If well telescopes please sketch and show depths.

GROUND LEVEL

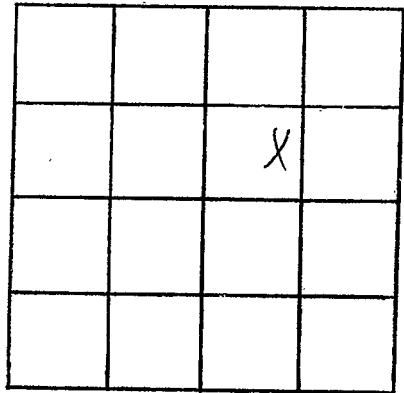

SECTION 33

Please indicate well location X.

ADDITIONAL INFORMATION

Lined area for additional information.

If more than one screen, show locations of each on sketch.